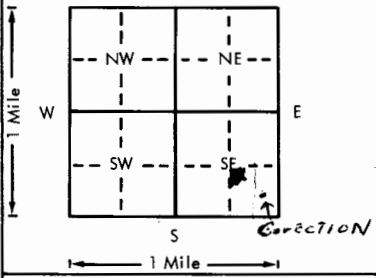


USE TYPEWRITER OR BALL
POINT PEN-PRESS FIRMLY,
PRINT CLEARLY.

WATER WELL RECORD
KSA 82a-1201-1215

Kansas Department of Health and
Environment-Division of Environment
(Water well Contractors)
Topeka, Kansas 66620

1. Location of well:		County <u>Rego</u>	Section <u>SE 1/4 SE 1/4 SE 1/4</u>	Section number <u>4</u>	Township number <u>T 26 S R 8</u>	Range number <u>E/W</u>
2. Distance and direction from nearest town or city: <u>9 mi So. of Arlington Kans</u>		3. Owner of well: <u>Bruce F Shultz</u>		R.R. or street: <u>Arlington Kans</u>		
Street address of well location if in city: <u>on 14th Hi way</u>		City, state, zip code: <u>67514</u>				
4. Locate with "X" in section below:		Sketch map:		6. Bore hole dia. <u>7 1/4</u> in. Completion date <u>Jan 13-78</u> Well depth <u>54</u> ft.		
				7. Cable tool ☒ Rotary ☐ Driven ☐ Dug ☐ Hollow rod ☐ Jetted ☐ Bored ☐ Reverse rotary		
5. Type and color of material		From		To		8. Use: ☒ Domestic ☐ Public supply ☐ Industry ☐ Irrigation ☐ Air conditioning ☐ Stock ☐ Lawn ☐ Oil field water ☐ Other
<u>Top Soil</u>		<u>0</u>		<u>8</u>		9. Casing: Material <u>PLTS</u> Height: Above or <u>below</u> Threaded ☐ Welded ☐ Surface <u>12</u> in. RMP ☒ PVC ☐ Weight <u> </u> lbs./ft. Dia. <u>5</u> in. to <u>54</u> ft. depth Wall Thickness: inches or Dia. <u> </u> in. to <u> </u> ft. depth gage No. <u>200</u>
<u>Fine Brown Sand</u>		<u>8</u>		<u>35</u>		10. Screen: Manufacturer's name <u>R. & S.</u> Type <u>RMP</u> Dia. <u>5"</u> Slot/gauze <u>1/8"</u> Length <u>10'</u> Set between <u>44</u> ft. and <u>54</u> ft. <u> </u> ft. and <u> </u> ft.
<u>Black Clay</u>		<u>35</u>		<u>45</u>		Gravel pack? ☒ Size range of material <u>48-3/8"</u>
<u>Medium Coarse Sand</u>		<u>45</u>		<u>54</u>		11. Static water level: <u>9</u> ft. below land surface Date <u>Jan 13-78</u> <u>mo./day/yr.</u>
<u>Red Bed</u>		<u>54</u>				12. Pumping level below land surfaces: <u>19</u> ft. after <u>1</u> hrs. pumping <u>12</u> g.p.m. <u> </u> ft. after <u> </u> hrs. pumping <u> </u> g.p.m. Estimated maximum yield <u> </u> g.p.m.
						13. Water sample submitted: <u> </u> mo./day/yr. ☐ Yes ☒ No Date <u> </u>
						14. Well head completion: ☒ Pitless adapter <u>12</u> Inches above grade
						15. Well grouted? <u> </u> With: <u> </u> Neat cement <u> </u> Bentonite ☒ Concrete Depth: From <u>3</u> ft. to <u>15</u> ft.
						16. Nearest source of possible contamination: ft. <u>400</u> Direction <u>NW</u> Type <u>Shap. Pn</u> Well disinfected upon completion? ☐ Yes ☐ No
						17. Pump: ☒ Not installed Manufacturer's name <u> </u> Model number <u> </u> HP <u> </u> Volts <u> </u> Length of drop pipe <u> </u> ft. capacity <u> </u> g.p.m. Type: ☐ Submersible ☐ Turbine ☐ Jet ☐ Reciprocating ☐ Centrifugal ☐ Other
18. Elevation:		19. Remarks:		20. Water well contractor's certification: This well was drilled under my jurisdiction and this report is true to the best of my knowledge and belief. <u>Wells Drilling Co.</u> <u>112</u> Business name <u>1030 Hiway 54 West</u> License No. <u> </u> Address <u>Dal Wells</u> Date <u>Jan 13-78</u> Signed <u>Dal Wells</u> Authorized representative		

Forward the white, blue and pink copies to the Department of Health and Environment

Form WWC-5