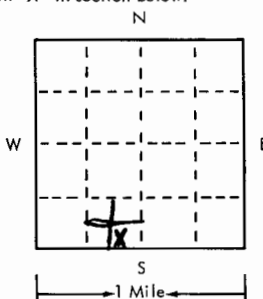
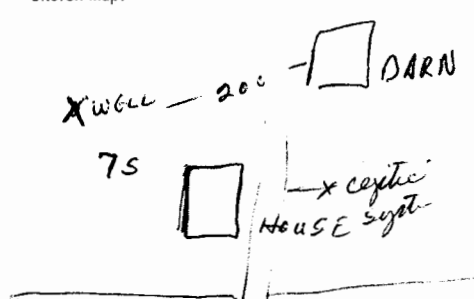


USE TYPEWRITER OR BALL
POINT PEN-PRESS FIRMLY,
PRINT CLEARLY.

WATER WELL RECORD
KSA 82a-1201-1215

26 8 W 7 SE SW 1/4 8
T R EW sec 1/4 1/4 1/4 No.

Kansas State Dept. Of Health
(Water Well Contractors)
Forbes-Bldg. 740
Topeka, Kansas 66620

1 Location of well:	County RENO	Township name LODA	Fraction SE SE SW 1/4 1/4 1/4	Section number 8	Town number 26-8	Range number R 8 W	
Distance and direction from nearest town or city: Street address of well location if in city:			3 Owner of well: Lyle Mc Kenney Address: RT. 1 Arlington, Kansas				
Locate with "X" in section below: 			Sketch map: 			4 Well depth: 38 ft. Date of completion 7-8 Well diameter 9 in.	
2 Type and color of material			From		To		
			Top Soil		0	3	
			Fine sand		3	15	
			TAN CLAY		15	20	
			Coarse gravel		20	37	
Red Shale		37	38				
					5 ☐ Cable tool ☒ Rotary ☐ Driven ☐ Dug ☐ Hollow rod ☐ Jetted ☐ Bored ☐ Reverse rotary		
			6 Use: ☒ Domestic ☐ Public supply ☐ Industry ☐ Irrigation ☐ Air conditioning ☐ Commercial ☐ Test well		7 Casing: Material RMB Height: above/below Threaded ☐ Welded ☐ Surface 12 in. Diam. 6 in. to 38 ft. depth Drive shoe? ☐ Yes ☒ No in. to ft. depth		
			8 Screen: Manufacturer Jess & Lowe Type RM 8 Dia. 6" Slot/gauze 1/16 Length 10' Set between 28 ft. and 38 ft. Fittings: Gravel pack ☐ Yes ☒ No Size range of material		9 Static water level: 11 ft. below land surface Date 7-8		
			10 Pumping level below land surfaces: 15 ft. after 1 hrs. pumping 15 g.p.m. ft. after hrs. pumping g.p.m. Estimated maximum yield 15-30 g.p.m.		11 Water sample submitted: ☐ Yes ☒ No Date		
			12 Well head completion: ☐ Pitless adapter ☒ 2 inches above grade		13 Well grouted? ☒ Yes ☐ No ☒ Neat cement ☐ Bentonite Depth: From 13 ft. to 3 ft.		
			14 Nearest source of possible contamination: ft. 125 Direction EAST Type Septic Well disinfected upon completion? ☒ Yes ☐ No		15 Pump: ☒ Not installed Manufacturer's name Model number HP Volts Length of drop pipe ft. capacity g.m.p. Type: ☐ Submersible ☐ Turbine ☐ Jet ☐ Reciprocating ☐ Centrifugal ☐ Other		
16 Remarks: elevation 1658' Customer's own slab Topography: ☐ Hill ☐ Slope ☒ Upland ☐ Valley			17 Water well contractor's certification: This well was drilled under my jurisdiction and this report is true to the best of my knowledge and belief. McLean Drilling Co. 227 Business name License No. Address RR 3 Hutchinson Signed Billy J. McLean Date 8-3-77 Authorized representative				

Forward the white, blue and pink copies to the Kansas State Dept. Of Health.

Form WWC-5