

Site 40, well #2

WATER WELL RECORD

Form WWC-5

KSA 82a-1212

LOCATION OF WATER WELL	Fraction	Section Number	Township Number	Range Number
County: <u>Pano</u>	<u>SW 1/4 SW 1/4 SE 1/4</u>	<u>31</u>	<u>T 26 S</u>	<u>R 9 E</u>

Distance and direction from nearest town or city?

8 miles S, 1 1/2 miles W of Langdon

Street address of well if located within city?

WATER WELL OWNER:

RR#, St. Address, Box # K65/GWMD#5

Board of Agriculture, Division of Water Resources

City, State, ZIP Code

Application Number:

DEPTH OF COMPLETED WELL 161 ft. Bore Hole Diameter 7 7/8 in. to ft. and in. to

Well Water to be used as:

- | | | | | |
|--------------|--------------|--------------------------|---------------------|--------------------------|
| 1 Domestic | 3 Feedlot | 6 Oil field water supply | 9 Dewatering | 11 Injection well |
| 2 Irrigation | 4 Industrial | 7 Lawn and garden only | 10 Observation well | 12 Other (Specify below) |

ResearchWell's static water level 52.8 ft. below land surface measured on Jan month 28 day 1983 year

Pump Test Data: Well water was ft. after hours pumping. gpm

Est. Yield gpm: Well water was ft. after hours pumping. gpm

TYPE OF BLANK CASING USED:

- | | | | | |
|---------|------------|-------------------|-------------------------|---------------------------------------|
| 1 Steel | 3 RMP (SR) | 6 Asbestos-Cement | 9 Other (specify below) | Casing Joints: Glued <u>X</u> Clamped |
| 2 PVC | 4 ABS | 7 Fiberglass | | Welded |

Threaded

Blank casing dia 5 in. to ft. Dia in. to ft. Dia in. toCasing height above land surface 10 in. weight lbs./ft. Wall thickness or gauge No Schedule 1120

TYPE OF SCREEN OR PERFORATION MATERIAL:

- | | | | | |
|---------|--------------------|-----------------|------------|--------------------|
| 1 Steel | 3 Stainless steel | 5 Fiberglass | 8 RMP (SR) | 10 Asbestos-cement |
| 2 Brass | 4 Galvanized steel | 6 Concrete tile | 9 ABS | 11 Other (specify) |

12 None used (open hole)

Screen or Perforation Openings Are:

- | | | | |
|--------------------|---------------|----------------|--------------------|
| 1 Continuous slot | 3 Mill slot | 6 Wire wrapped | 9 Drilled holes |
| 2 Louvered shutter | 4 Key punched | 7 Torch cut | 10 Other (specify) |

11 None (open hole)

Screen-Perforation Dia 5 in. to ft. Dia in. to ft. Dia in. toScreen-Perforated Intervals: From 161 ft. to 156 ft. From ft. to ft. From ft. to ft. From ft. to ft.Gravel Pack Intervals: From 161 ft. to 146 ft. From ft. to ft. From ft. to ft. From ft. to ft.GROUT MATERIAL: Neat cement 2 Cement grout 3 Bentonite 4 OtherGrouted Intervals: From 146 ft. to 104 ft. From ft. to ft. From ft. to ft. From ft. to ft.

What is the nearest source of possible contamination:

- | | | | | |
|-----------------|---------------|------------------|---------------------------|--------------------------|
| 1 Septic tank | 4 Cess pool | 7 Sewage lagoon | 10 Fuel storage | 14 Abandoned water well |
| 2 Sewer lines | 5 Seepage pit | 8 Feed yard | 11 Fertilizer storage | 15 Oil well/Gas well |
| 3 Lateral lines | 6 Pit privy | 9 Livestock pens | 12 Insecticide storage | 16 Other (specify below) |
| | | | 13 Watertight sewer lines | |

Direction from well How many feet ? Water Well Disinfected? Yes No

Was a chemical/bacteriological sample submitted to Department? Yes No If yes, date sample

was submitted month day year: Pump Installed? Yes No

If Yes: Pump Manufacturer's name Model No. HP Volts

Depth of Pump Intake ft. Pumps Capacity rated at gal./min

Type of pump: 1 Submersible 2 Turbine 3 Jet 4 Centrifugal 5 Reciprocating 6 Other

CONTRACTOR'S OR LANDOWNER'S CERTIFICATION: This water well was (1) constructed, (2) reconstructed, or (3) plugged under my jurisdiction and was


completed on July month 8 day 1982 year

and this record is true to the best of my knowledge and belief. Kansas Water Well Contractor's License No.

This Water Well Record was completed on month day year under the business

name of by (signature)

LOCATE WELL'S LOCATION WITH AN "X" IN SECTION BOX:

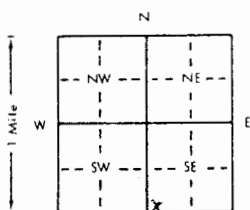ELEVATION: 1735.33


FROM	TO	LITHOLOGIC LOG	FROM	TO	LITHOLOGIC LOG
0	4	dark brown sandy loam	110	161	Sandy clay and sand
4	8	brown sandy clay			decrease in clay with
8	20	sand and gravel			depth
20	39	light grey to white sandy clay			(abbreviated log)
39	55	becoming silty with depth			
55	58	light grey to tan silty clay			
58	100	decrease in sand with depth			
100	110	reddish brown sandy clay			
		sand and gravel			
		orange brown silty clay			

Depth(s) Groundwater Encountered 1. ft. 2. ft. 3. ft. 4. ft. (Use a second sheet if needed)

INSTRUCTIONS: Use typewriter or ball point pen, please press firmly and PRINT clearly. Please fill in blanks, underline or circle the correct answers. Send top three copies to Kansas Department of Health and Environment, Division of Environment, Water Well Contractors, Topeka, KS 66620. Send one to WATER WELL OWNER and retain one for your records.

SITE NUMBER : 40 (KP15)
SITE LOCATION : SW SW SE
LEGAL LOCATION: 31-26-9W
COUNTY : RENO

LANDOWNER: Mrs. Jimmy Claypool
ADDRESS : RR
Penalosa, KS
PHONE NO.: (316)-644-7164

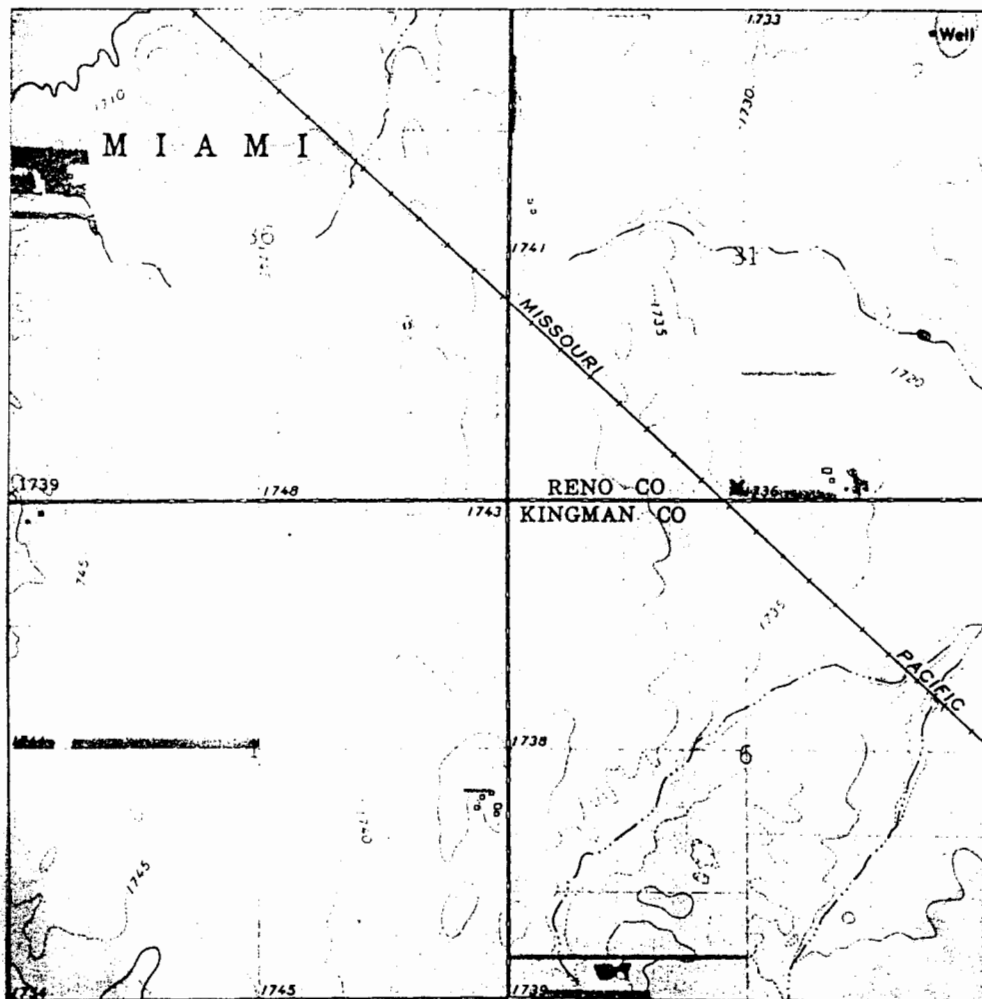

WELL LOCATION *

LEGAL LOCATION: 31-26-9W
COUNTY : RENO

[illegible]