

Site 40, well #3

WATER WELL RECORD

Form WWC-5


KSA 82a-1212

LOCATION OF WATER WELL	Fraction	Section Number	Township Number	Range Number	
County: <u>Reno</u>	<u>SW 1/4 SW 1/4 SE 1/4</u>	<u>31</u>	<u>T 26 S</u>	<u>R 9 EW</u>	
Distance and direction from nearest town or city? <u>8 miles S, 1 1/2 miles W of Langdon</u>		Street address of well if located within city?	
WATER WELL OWNER: <u>KGS/GWMD#5</u>	
R#, St. Address, Box #		Board of Agriculture, Division of Water Resources	
City, State, ZIP Code		Application Number:	
DEPTH OF COMPLETED WELL: <u>102</u> ft. Bore Hole Diameter: <u>9 7/8</u> in. to _____ ft., and _____ in. to _____	
Well Water to be used as:	
1 Domestic 3 Feedlot		5 Public water supply		8 Air conditioning	
2 Irrigation 4 Industrial		6 Oil field water supply		9 Dewatering	
		7 Lawn and garden only		10 Observation well	
				11 Injection well	
				12 Other (Specify below) <u>Research</u>	
Well's static water level: <u>52.4</u> ft. below land surface measured on <u>Jan</u> month <u>28</u> day <u>1983</u> year	
Pump Test Data: Well water was _____ ft. after _____ hours pumping _____ gpm	
Est. Yield _____ gpm: Well water was _____ ft. after _____ hours pumping _____ gpm	
TYPE OF BLANK CASING USED:	
1 Steel		3 RMP (SR)	5 Wrought iron	8 Concrete tile	
2 PVC		4 ABS	6 Asbestos-Cement	9 Other (specify below)	
			7 Fiberglass	Casing Joints: Glued ☒ Clamped _____	
				Welded _____	
				Threaded _____	
Blank casing dia: <u>5</u> in. to _____ ft., Dia _____ in. to _____ ft., Dia _____ in. to _____	
Casing height above land surface: <u>16</u> in., weight _____ lbs./ft. Wall thickness or gauge No. <u>schedule 1120</u>	
TYPE OF SCREEN OR PERFORATION MATERIAL:	
1 Steel		3 Stainless steel	5 Fiberglass	8 RMP (SR)	
2 Brass		4 Galvanized steel	6 Concrete tile	9 ABS	
				10 Asbestos-cement	
				11 Other (specify)	
				12 None used (open hole)	
Screen or Perforation Openings Are:	
1 Continuous slot		3 Mill slot	5 Gauzed wrapped	8 Saw cut	
2 Louvered shutter		4 Key punched	6 Wire wrapped	9 Drilled holes	
			7 Torch cut	10 Other (specify)	
				11 None (open hole)	
Screen-Perforation Dia: <u>5</u> in. to _____ ft., Dia _____ in. to _____ ft., Dia _____ in. to _____	
Screen-Perforated Intervals: From <u>102</u> ft. to <u>97</u> ft., From _____ ft. to _____ ft., From _____ ft. to _____ ft.	
Gravel Pack Intervals: From <u>102</u> ft. to <u>89</u> ft., From _____ ft. to _____ ft., From _____ ft. to _____ ft.	
GROUT MATERIAL: 1 Neat cement 2 Cement grout 3 Bentonite 4 Other	
Grouted Intervals: From <u>89</u> ft. to <u>79</u> ft., From _____ ft. to _____ ft., From _____ ft. to _____ ft.	
What is the nearest source of possible contamination:	
1 Septic tank		4 Cess pool	7 Sewage lagoon	10 Fuel storage	
2 Sewer lines		5 Seepage pit	8 Feed yard	11 Fertilizer storage	
3 Lateral lines		6 Pit privy	9 Livestock pens	12 Insecticide storage	
				13 Watertight sewer lines	
				14 Abandoned water well	
				15 Oil well/Gas well	
				16 Other (specify below)	
Direction from well _____ How many feet _____ ? Water Well Disinfected? Yes _____ No _____	
Has a chemical/bacteriological sample submitted to Department? Yes _____ No _____ If yes, date sample _____	
Was submitted _____ month _____ day _____ year: Pump Installed? Yes _____ No _____	
If Yes: Pump Manufacturer's name _____ Model No. _____ HP _____ Volts _____	
Depth of Pump Intake _____ ft. Pumps Capacity rated at _____ gal./min	
Type of pump: 1 Submersible 2 Turbine 3 Jet 4 Centrifugal 5 Reciprocating 6 Other	
CONTRACTOR'S OR LANDOWNER'S CERTIFICATION: This water well was (1) constructed, (2) reconstructed, or (3) plugged under my jurisdiction and was completed on _____ July _____ month _____ 8 _____ day _____ 1982 _____ year	
and this record is true to the best of my knowledge and belief. Kansas Water Well Contractor's License No. _____	
This Water Well Record was completed on _____ month _____ day _____ year under the business _____	
name of _____ by (signature) _____	
LOCATE WELL'S LOCATION WITH AN "X" IN SECTION BOX:	
ELEVATION: <u>1235.35</u>	
<table border="1" style="width:100%; border-collapse: collapse;"> <thead> <tr> <th>FROM</th> <th>TO</th> <th>LITHOLOGIC LOG</th> <th>FROM</th> <th>TO</th> <th>LITHOLOGIC LOG</th> </tr> </thead> <tbody> <tr> <td>0</td> <td>4</td> <td>dark brown sandy loam</td> <td></td> <td></td> <td></td> </tr> <tr> <td>4</td> <td>8</td> <td>brown sandy clay</td> <td></td> <td></td> <td></td> </tr> <tr> <td>8</td> <td>20</td> <td>sand and gravel</td> <td></td> <td></td> <td></td> </tr> <tr> <td>20</td> <td>39</td> <td>light grey to white sandy clay becoming silty with depth</td> <td></td> <td></td> <td></td> </tr> <tr> <td>39</td> <td>55</td> <td>light grey to tan sandy clay decrease in sand with depth</td> <td></td> <td></td> <td></td> </tr> <tr> <td>55</td> <td>58</td> <td>reddish brown sandy clay</td> <td></td> <td></td> <td></td> </tr> <tr> <td>58</td> <td>100</td> <td>sand and gravel</td> <td></td> <td></td> <td></td> </tr> <tr> <td>100</td> <td>110</td> <td>range (abbreviated log)</td> <td></td> <td></td> <td></td> </tr>
Depth(s) Groundwater Encountered 1. _____ ft. 2. _____ ft. 3. _____ ft. 4. _____ ft. (Use a second sheet if needed)	

INSTRUCTIONS: Use typewriter or ball point pen, please press firmly and PRINT clearly. Please fill in blanks, underline or circle the correct answers. Send top three copies to Kansas Department of Health and Environment, Division of Environment, Water Well Contractors, Topeka, KS 66620. Send one to WATER WELL OWNER and retain one for your records.

SITE NUMBER : 40 (KP15)
SITE LOCATION : SW SW SE
LEGAL LOCATION: 31-26-9W
COUNTY : RENO

LANDOWNER: Mrs. Jimmy Claypool
ADDRESS : RR
Penalosa, KS
PHONE NO.: (316)-644-7164

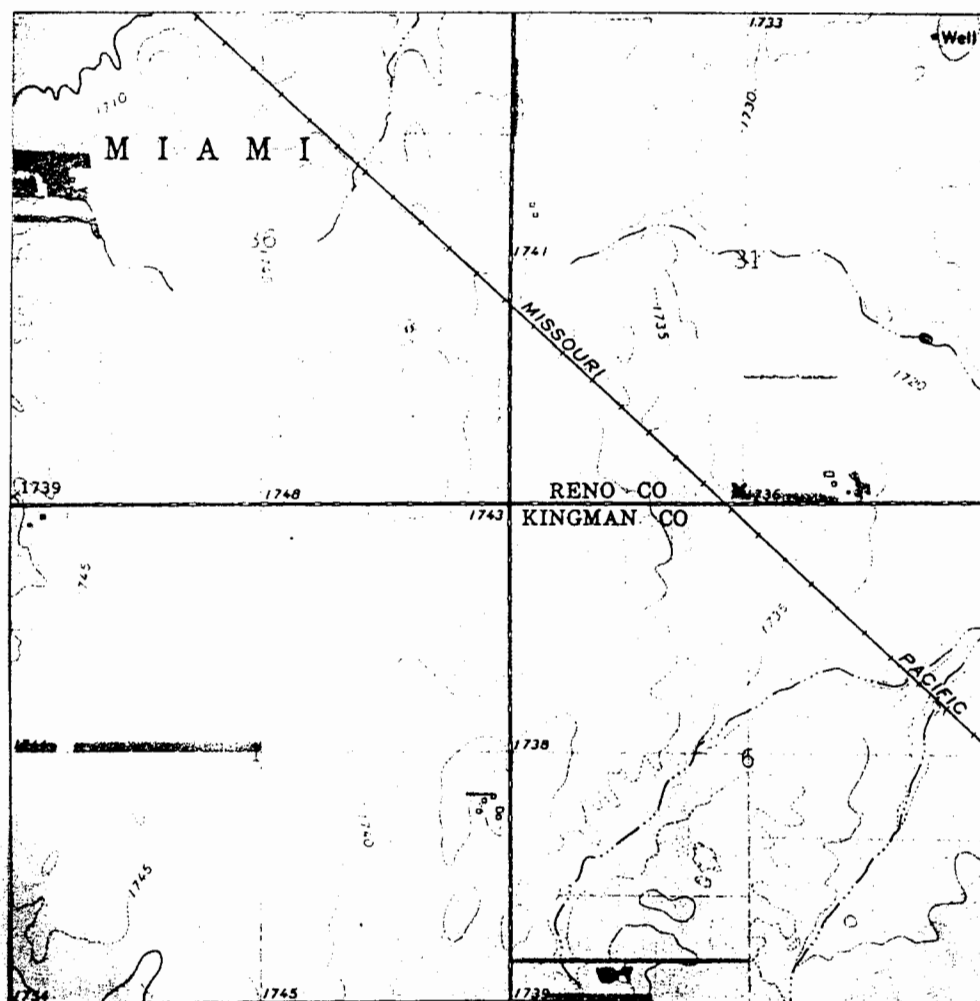

WELL LOCATION *

BIG BEND GMD#5-KGS
WATER QUALITY
OBSERVATION WELL
NETWORK

SITE NUMBER : 40 (KP15)
SITE LOCATION: SW SW SE

LEGAL LOCATION: 31-26-9W
COUNTY : RENO

WELL LOG

[illegible]