

Site 40, well #1

WATER WELL RECORD

Form WWC-5

KSA 82a-1212

LOCATION OF WATER WELL	Fraction <u>NE</u> <u>1/4</u> <u>SE</u> <u>1/4</u> <u>NE</u> <u>1/4</u>	Section Number <u>35</u>	Township Number <u>T 26</u> <u>S</u>	Range Number <u>R 9</u> <u>EW</u>
------------------------	---	--------------------------	--------------------------------------	-----------------------------------

Distance and direction from nearest town or city?

3 miles E., 1 3/4 miles N of Penolosca

Street address of well if located within city?

WATER WELL OWNER:

RR#, St. Address, Box #

KGS/GWMD #5

City, State, ZIP Code

Board of Agriculture, Division of Water Resources

Application Number:

DEPTH OF COMPLETED WELL... 103 ft. Bore Hole Diameter... 9 7/8 in. to ... ft. and ... in. to ...

Well Water to be used as:

5 Public water supply

8 Air conditioning

11 Injection well

1 Domestic

3 Feedlot

6 Oil field water supply

9 Dewatering

12 Other (Specify below)

2 Irrigation

4 Industrial

7 Lawn and garden only

10 Observation well

ResearchWell's static water level... 1.6 ft. below land surface measured on... Jan month... 28 day... 1983 year

Pump Test Data

Well water was

ft. after

hours pumping

Est. Yield

gpm

Well water was

ft. after

hours pumping

gpr

TYPE OF BLANK CASING USED:

5 Wrought iron

8 Concrete tile

Casing Joints: Glued X Clamped

1 Steel

3 RMP (SR)

6 Asbestos-Cement

9 Other (specify below)

Welded

PVC

4 ABS

7 Fiberglass

Threaded

Blank casing dia... 5 in. to ... ft., Dia... in. to ... ft., Dia... in. to ...Casing height above land surface... 36 in., weight... lbs./ft. Wall thickness or gauge No. Schedule 11.70

TYPE OF SCREEN OR PERFORATION MATERIAL:

1 Steel

3 Stainless steel

5 Fiberglass

PVC

10 Asbestos-cement

2 Brass

4 Galvanized steel

6 Concrete tile

8 RMP (SR)

11 Other (specify)

9 ABS

12 None used (open hole)

Screen or Perforation Openings Are:

1 Continuous slot

3 Mill slot

5 Gauzed wrapped

8 Saw cut

11 None (open hole)

2 Louvered shutter

4 Key punched

6 Wire wrapped

9 Drilled holes

7 Torch cut

10 Other (specify)

Screen-Perforation Dia... 5 in. to ... ft., Dia... in. to ... ft., Dia... in. to ...Screen-Perforated Intervals: From... 103 ft. to... 98 ft., From... ft. to... ft., From... ft. to... ft.Gravel Pack Intervals: From... 103 ft. to... 91 ft., From... ft. to... ft., From... ft. to... ft.

Gravel Pack Intervals: From... ft. to... ft., From... ft. to... ft., From... ft. to... ft.

GROUT MATERIAL:

1 Neat cement

2 Cement grout

3 Bentonite

4 Other

Grouted Intervals: From... 91 ft. to... 35 ft., From... ft. to... ft., From... ft. to... ft.

What is the nearest source of possible contamination:

1 Septic tank

4 Cess pool

7 Sewage lagoon

10 Fuel storage

14 Abandoned water well

2 Sewer lines

5 Seepage pit

8 Feed yard

11 Fertilizer storage

15 Oil well/Gas well

3 Lateral lines

6 Pit privy

9 Livestock pens

12 Insecticide storage

16 Other (specify below)

13 Watertight sewer lines

Direction from well... How many feet... ? Water Well Disinfected? Yes... No

Was a chemical/bacteriological sample submitted to Department? Yes... No

Was submitted... month... day... year: Pump Installed? Yes... No

If Yes: Pump Manufacturer's name... Model No... HP... Volts

Depth of Pump Intake... ft. Pumps Capacity rated at... gal./min

Type of pump: 1 Submersible 2 Turbine 3 Jet 4 Centrifugal 5 Reciprocating 6 Other

CONTRACTOR'S OR LANDOWNER'S CERTIFICATION: This water well was (1) constructed, (2) reconstructed, or (3) plugged under my jurisdiction and was


completed on... July month... 15 day... 1982 year

and this record is true to the best of my knowledge and belief. Kansas Water Well Contractor's License No.

This Water Well Record was completed on... month... day... year under the business

name of... by (signature)

7 LOCATE WELL'S LOCATION WITH AN "X" IN SECTION BOX:

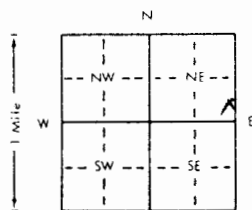

FROM	TO	LITHOLOGIC LOG	FROM	TO	LITHOLOGIC LOG
0	3	dark brown sandy loam			
3	18	sand and gravel			
18	20	light grey silty, sandy clay			
20	34	fine grained sand			
34	42	yellow ochre slightly silty clay interbedded with a light grey silty clay			
42	83	sand and gravel			
83	103	red shale			

ELEVATION: 1654.5

Depth(s) Groundwater Encountered 1... ft. 2... ft. 3... ft. 4... ft.


(Use a second sheet if needed)

INSTRUCTIONS: Use typewriter or ball point pen, please press firmly and PRINT clearly. Please fill in blanks, underline or circle the correct answers. Send top three copies to Kansas Department of Health and Environment, Division of Environment, Water Well Contractors, Topeka, KS 66620. Send one to WATER WELL OWNER and retain one for your records.

[illegible]

SITE NUMBER : 41 (KP16)
SITE LOCATION : NE SE NE
LEGAL LOCATION: 35-26-9W
COUNTY : RENO

LANDOWNER: John Reece
ADDRESS : Rt. 1
Langdon, KS
PHONE NO.: (316)-596-2515

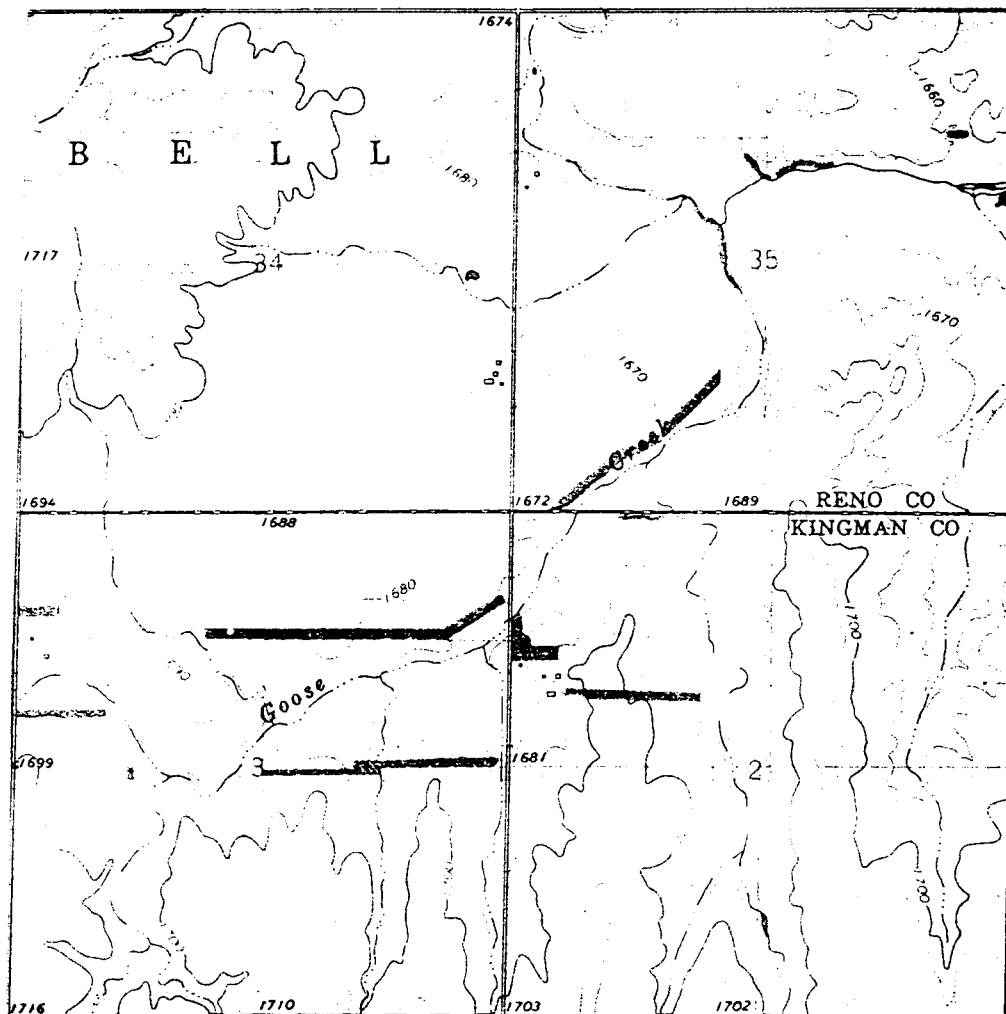

WELL LOCATION *