

LOCATION OF WATER WELL	Fraction	Section Number	Township Number	Range Number
County: <u>Pen</u>	<u>NE 1/4 SE 1/4 NE 1/4</u>	<u>35</u>	<u>T 26 S</u>	<u>R 9 EW</u>
Distance and direction from nearest town or city? <u>3 miles E., 1 3/4 miles N. of Penabosc</u>		Street address of well if located within city?		
WATER WELL OWNER: RR#, St. Address, Box # City, State, ZIP Code		Board of Agriculture, Division of Water Resources Application Number:		
DEPTH OF COMPLETED WELL: <u>34</u> ft. Bore Hole Diameter: <u>9 7/8</u> in. to ft., and in. to				
Well Water to be used as:				
1 Domestic	3 Feedlot	6 Oil field water supply	9 Dewatering	11 Injection well
2 Irrigation	4 Industrial	7 Lawn and garden only	10 Observation well	<u>12 Other (Specify below)</u> <u>Research</u>
Well's static water level: <u>2.2</u> ft. below land surface measured on <u>Jan</u> month <u>28</u> day <u>1983</u> year				
Pump Test Data: Well water was ft. after hours pumping gpm				
Est. Yield: gpm: Well water was ft. after hours pumping gpm				
TYPE OF BLANK CASING USED:				
1 Steel	3 RMP (SR)	6 Asbestos-Cement	9 Other (specify below)	Casing Joints: Glued ☒ Clamped
<u>2 PVC</u>	4 ABS	7 Fiberglass		Welded
Blank casing dia: <u>5</u> in. to ft., Dia in. to ft., Dia in. to	Threaded			
Casing height above land surface: <u>36</u> in., weight lbs./ft. Wall thickness or gauge No. <u>Schedule 1120</u>				
TYPE OF SCREEN OR PERFORATION MATERIAL:				
1 Steel	3 Stainless steel	5 Fiberglass	8 RMP (SR)	10 Asbestos-cement
2 Brass	4 Galvanized steel	6 Concrete tile	9 ABS	11 Other (specify)
Screen or Perforation Openings Are:				
1 Continuous slot	<u>3</u> Mill slot	5 Gauzed wrapped	8 Saw cut	11 None (open hole)
2 Louvered shutter	4 Key punched	6 Wire wrapped	9 Drilled holes	
Screen-Perforation Dia: <u>5</u> in. to ft., Dia in. to ft., Dia in. to				
Screen-Perforated Intervals: From <u>34</u> ft. to <u>29</u> ft., From ft. to ft., From ft. to ft.				
Gravel Pack Intervals: From <u>34</u> ft. to <u>26</u> ft., From ft. to ft., From ft. to ft.				
GROUT MATERIAL: <u>1</u> Neat cement 2 Cement grout 3 Bentonite 4 Other				
Grouted Intervals: From <u>0</u> ft. to <u>10</u> ft., From ft. to ft., From ft. to ft.				
What is the nearest source of possible contamination:				
1 Septic tank	4 Cess pool	7 Sewage lagoon	10 Fuel storage	14 Abandoned water well
2 Sewer lines	5 Seepage pit	8 Feed yard	11 Fertilizer storage	15 Oil well/Gas well
3 Lateral lines	6 Pit privy	9 Livestock pens	12 Insecticide storage	16 Other (specify below)
13 Watertight sewer lines				
Direction from well How many feet ? Water Well Disinfected? Yes No				
Has a chemical/bacteriological sample submitted to Department? Yes No If yes, date sample was submitted month day year: Pump Installed? Yes No				
If Yes: Pump Manufacturer's name Model No. HP Volts				
Depth of Pump Intake ft. Pumps Capacity rated at gal./min				
Type of pump: 1 Submersible 2 Turbine 3 Jet 4 Centrifugal 5 Reciprocating 6 Other				
CONTRACTOR'S OR LANDOWNER'S CERTIFICATION: This water well was (1) constructed, (2) reconstructed, or (3) plugged under my jurisdiction and was completed on <u>July</u> month <u>16</u> day <u>1982</u> year				
and this record is true to the best of my knowledge and belief. Kansas Water Well Contractor's License No.				
This Water Well Record was completed on month day year under the business name of by (signature)				
LOCATE WELL'S LOCATION WITH AN "X" IN SECTION BOX:		FROM TO LITHOLOGIC LOG		
ELEVATION: <u>1654.3</u>		FROM TO LITHOLOGIC LOG		

dark brown sandy loam
sand and gravel
light grey silty, sandy clay
fine grained sand
(abbreviated log)

BIG BEND GMD#5-KGS
WATER QUALITY
OBSERVATION WELL
NETWORK

SITE NUMBER : 41 (KP16)
SITE LOCATION: NE SE NE


LEGAL LOCATION: 35-26-9W
COUNTY : RENO

WELL LOG

[illegible]

SITE NUMBER : 41 (KP16)
SITE LOCATION : NE SE NE
LEGAL LOCATION: 35-26-9W
COUNTY : RENO

LANDOWNER: John Reece
ADDRESS : Rt. 1
Langdon, KS
PHONE NO.: (316)-596-2515

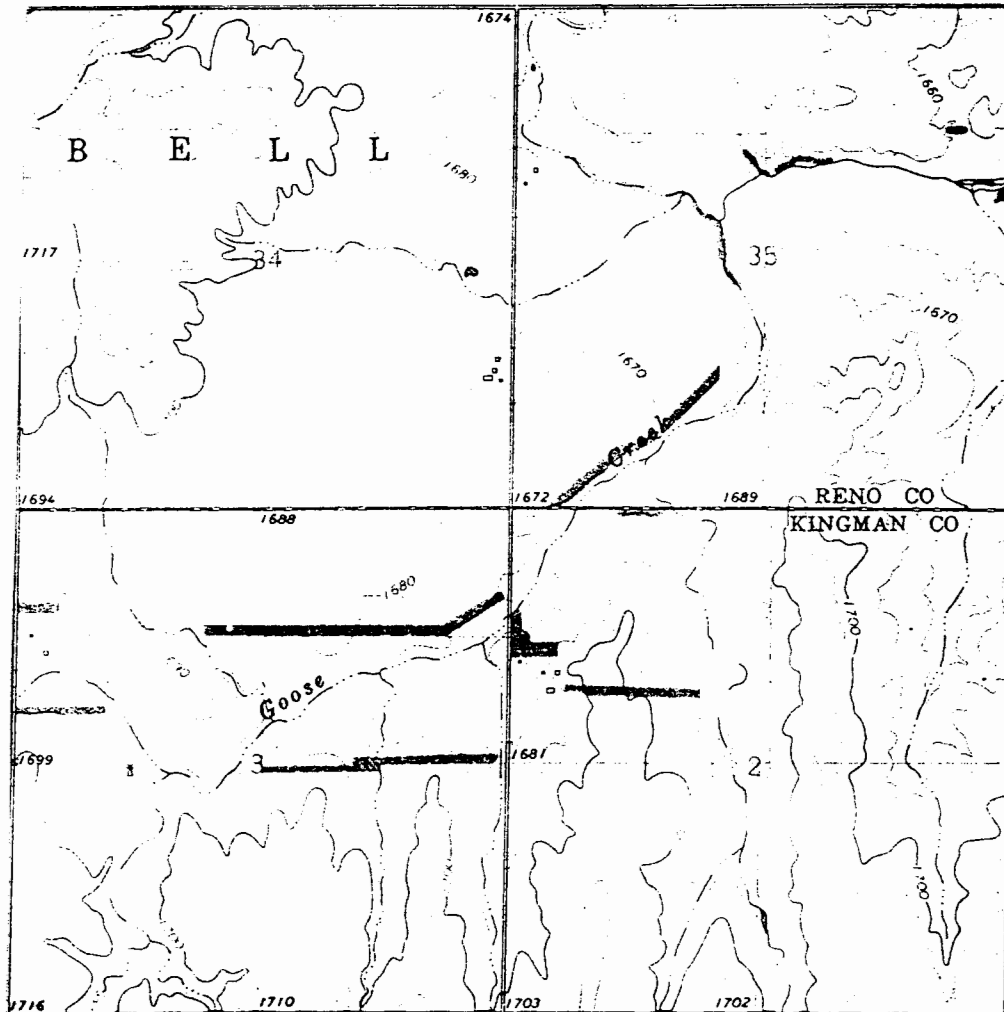

WELL LOCATION ★