


1 LOCATION OF WATER WELL: Sedgwick	FRACTION SE 1/4 SE 1/4 SW 1/4	Section Number 3	Township Number T 27 S	Range Number R 1W E/W
---	---	----------------------------	----------------------------------	---------------------------------

Distance and direction from nearest town or city street address of well if located within city?
3/8 mile E. of of 21st N. & Ridge (N. side of street) Wichita, KS.

2 WATER WELL OWNER: CITY OF WICHITA PHYSICAL ADDRESS, BOX #: P.O. Box 9163 CITY, STATE, ZIP CODE: Wichita, Kansas 67277	Board of Agriculture, Division of Water Resource Application Number: 950276
---	---

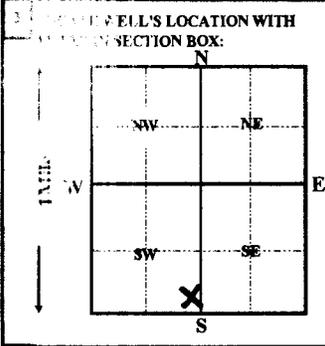

4 DEPTH OF COMPLETED WELL **40** ft. ELEVATION:

Depth(s) groundwater Encountered **1** ft. **2** ft. **3** ft.

WELL'S STATIC WATER LEVEL **10** FT. BELOW LAND SURFACE MEASURED ON **11/28/1995**

Pump test data: Well water was _____ ft. after _____ hours pumping _____ gpm

Est. Yield _____ gpm: Well water was _____ ft. after _____ hours pumping _____ gpm

Bore Hole Diameter **unknown** in. to _____ ft. and _____ in. to _____ ft.

WELL WATER USED AS:

1 Domestic	3 Feedlot	6 Oil field water supply	9 Dewatering	12 Other (Specify below)
2 Irrigation	4 Industrial	7 Lawn and garden only	10 Monitoring well	

WAS A CHEMICAL/BACTERIOLOGICAL SAMPLE SUBMITTED TO DEPARTMENT? Yes _____ No ; If yes, mo/day/yr sample was submitted _____

Water Well Disinfected? Yes No _____

5 TYPE OF CASING USED:

1 Steel	3 RMP (SR)	5 Wrought iron	8 Concrete tile	CASING JOINTS: Glued	Clamped
2 PVC	4 ABS	6 Asbestos-Cement	9 Other (Specify below)	Welded	Threaded
		7 Fiberglass			

Blank casing Diameter **8** in. to _____ ft., Dia _____ in. to _____ ft.

Casing height below land surface **36** in., weight _____ lbs./ft. Wall thickness or gauge No. _____

TYPE OF SCREEN OR PERFORATION MATERIAL:

1 Steel	3 Stainless Steel	5 Fiberglass	8 RMP (SR)	11 other (specify) N/A
2 Brass	4 Galvanized steel	6 Concrete tile	9 ABS	12 None used (open hole)

SCREEN OR PERFORATION OPENING ARE:

1 Continuous slot	3 Mill slot	5 Gauzed wrapped	8 Saw cut	11 None (open hole)
2 Laminated shutter	4 Key punched	6 Wire wrapped	9 Drilled holes	
		7 Torch cut	10 Other (specify) N/A	

SCREEN PERFORATION INTERVALS: from _____ ft. to _____ ft., From _____ ft. to _____ ft.

GRAVEL PACK INTERVALS: from _____ ft. to _____ ft., From _____ ft. to _____ ft.

6 GROUT MATERIAL: 1 Neat cement 2 Cement grout 3 Bentonite 4 Other **bentonite hole plug**

Grout intervals: From **3** ft. to **10** ft. From _____ ft. to _____ ft.

What is the nearest source of possible contamination:

1 Septic tank	4 Lateral lines	7 Pit privy	10 Livestock pens	14 Abandon water well
2 Sewer lines	5 Cess pool	8 Sewage lagoon	11 Fuel storage	15 Oil well/Gas well
3 Watertight sewer lines	6 Seepage pit	9 Feedyard	12 Fertilizer storage	16 Other (specify below)
			13 Insecticide storage	None Apparent

Direction from well? _____ How many feet? _____

FROM	TO	LITHOLOGIC LOG	FROM	TO	PLUGGING INTERVALS
			0	3	surface clay and silt
			3	10	bentonite hole plug
			10	40	chlorinated sand and gravel

7 CONTRACTOR'S OR LANDOWNER'S CERTIFICATION: This water well was (1) constructed, (2) reconstructed, or (3) plugged under my jurisdiction and was completed on (mo/day/year) **11/28/1995** and this record is true to the best of my knowledge and belief. Kansas Water Well Contractor's License No. **236** This Water Well Record was completed on (mo/day/yr) **11/29/95**

Under the business name of **Harp Well & Pump Service, Inc.** by (signature) *Jane Frederick*