Water Well Record Form WWC-5 KSA 82a-1212

1 LOCATION OF WATER WELL:	FRACTION	Section Number	Township Number	Range Number
Sedgwick	NW 1/4 SE 1/4 SE 1/4	14	T 27 S	R 1W E/W

Distance and direction from nearest town or city street address of well if located within city?

761 N. Florence Wichita, Kansas

WATER WELL OWNER: GREINER, Pat and OGAN, Norman

RR#, ST. ADRESS, BOX #: 761 N. Florence

CITY, STATE, ZIP CODE: Wichita, Kansas

Board of Agriculture, Divivsion of Water Resource

Application Number:

LOCATE WELL'S LOCATION WITH AN "X" IN SECTION BOX:

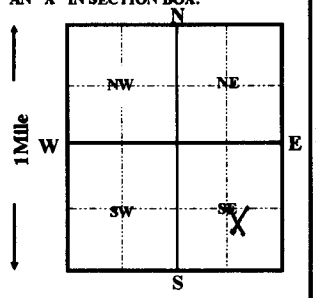

4 DEPTH OF ~~COMPLETED~~ PLUGGED WELL 20 ft. ELEVATION:

Depth(s) groundwater Encountered 1 ft. 2 ft. 3 ft.

WELL'S STATIC WATER LEVEL 10.5 FT. BELOW LAND SURFACE MEASURED ON mo/day/yr 6-24-96

Pump test data: Well water was ft. after hours pumping gpm

Est. Yield gpm: Well water was ft. after hours pumping gpm

Bore Hole Diameter unknown in. to ft. and in. to ft.

WELL WATER TO BE USED AS:

1 Domestic 3 Feedlot 5 Public water supply 8 Air conditioning 11 Injection well

2 Irrigation 4 Industrial 6 Oil field water supply 9 Dewatering 12 Other (Specify below)

7 Lawn and garden only 10 Monitoring well

Was a chemical/bacteriological sample submitted to Department? Yes No X ; If yes, mo/day/yr sample was submitted

Water Well Disinfected? Yes X No

5 TYPE OF CASING USED:

1 Steel 3 RMP (SR) 5 Wrought iron 8 Concrete tile CASING JOINTS: Glued Clamped

2 PVC 4 ABS 6 Asbestos-Cement 9 Other (Specify below) Welded

7 Fiberglass Threaded

Blank casing Diameter 1 1/4 in. to ft., Dia in. to ft., Dia in. to ft.

Casing height ~~above land surface~~ below 60 in., weight lbs. / ft. Wall thickness or gauge No.

TYPE OF SCREEN OR PERFORATION MATERIAL:

1 Steel 3 Stainless Steel 5 Fiberglass 7 PVC 10 Asbestos-cement

2 Brass 4 Galvanized steel 6 Concrete tile 8 RMP (SR) 9 ABS 11 other (specify) N/A 12 None used (open hole)

SCREEN OR PERFORATION OPENING ARE:

1 Continous slot 3 Mill slot 5 Gauzed wrapped 8 Saw cut 11 None (open hole)

2 Louvered shutter 4 Key punched 6 Wire wrapped 9 Drilled holes

7 Torch cut 10 Other (specify) N/A

SCREEN-PERFORATION INTERVALS: from ft. to ft., From ft. to ft.

from ft. to ft., From ft. to ft.

GRAVEL PACK INTERVALS: from ft. to ft., From ft. to ft.

from ft. to ft., From ft. to ft.

6 GROUT MATERIAL: 1 Neat cement 2 Cement grout 3 Bentonite 4 Other

Grout Intervals: From 0 ft. to 20 ft. From ft. to ft. From ft. to ft.

What is the nearest source of possible contamination:

1 Septic tank 4 Lateral lines 7 Pit privy 10 Livestock pens 14 Abandon water well

2 Sewer lines 5 Cess pool 8 Sewage lagoon 11 Fuel storage 15 Oil well/Gas well

3 Watertight sewer lines 6 Seepage pit 9 Feedyard 12 Fertilizer storage 16 Other (specify below)

13 Insecticide storage

Direction from well? North How many feet? 15

FROM	TO	LITHOLOGIC LOG	FROM	TO	PLUGGING INTERVALS
			0	20	cement grout

7 CONTRACTOR'S OR LANDOWNER'S CERTIFICATION: This water well was (1) constructed, (2) reconstructed, or (3) plugged under my jurisdiction and was completed on (mo/day/year) 06/24/1996 and this record is true to the best of my knowledge and belief. Kansas Water Well Contractor's License No. 236 This Water Well Record was completed on (mo/day/yr) 06/25/96

Under the business name of Harp Well & Pump Service, Inc by (signature)

Todd S. Harp