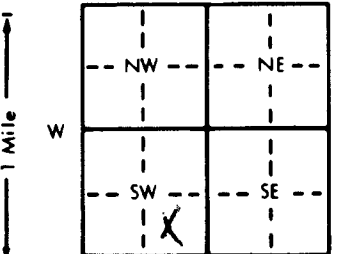


1 LOCATION OF WATER WELL: County: Setgewick Fraction: 1/4 Section, Number: 14 Township Number: 27 Range, Number: 1 EW

Distance and direction from nearest town or city street address of well if located within city? 9010 W Central Park Wichita KS

2 WATER WELL OWNER: Stacey Turner RR#, St. Address, Box #: 9010 W Central Park Board of Agriculture, Division of Water Resources City, State, ZIP Code: Wichita KS Application Number:

3 LOCATE WELL'S LOCATION WITH AN "X" IN SECTION BOX: 

4 DEPTH OF COMPLETED WELL: 62 ft. ELEVATION: 30 ft. Depth(s) Groundwater Encountered: 30 ft. 2. 30 ft. 3. 30 ft. WELL'S STATIC WATER LEVEL: 30 ft. below land surface measured on mo/day/yr 3-18-97 Pump test data: Well water was ON ft. after ON hours pumping ON gpm Est. Yield ON gpm: Well water was ON ft. after ON hours pumping ON gpm Bore Hole Diameter 10 in. to 62 ft. and ON in. to ON ft. WELL WATER TO BE USED AS: 5 Public water supply 8 Air conditioning 11 Injection well 1 Domestic 3 Feedlot 6 Oil field water supply 9 Dewatering 12 Other (Specify below) 2 Irrigation 4 Industrial 7 Lawn and garden only 10 Monitoring well Was a chemical/bacteriological sample submitted to Department? Yes Yes No No; If yes, mo/day/yr sample was submitted Water Well Disinfected? Yes Yes No No

5 TYPE OF BLANK CASING USED: 1 Steel 3 RMP (SR) 5 Wrought iron 8 Concrete tile CASING JOINTS: Glued Clamped 2 PVC 4 ABS 6 Asbestos-Cement 9 Other (specify below) Welded Threaded Blank casing diameter 5 in. to 62 ft. Dia 5 in. to 62 ft. Dia 5 in. to 62 ft. Dia 5 in. to 62 ft. Casing height above land surface 14 in. weight 26 lbs./ft. Wall thickness or gauge No. 26 TYPE OF SCREEN OR PERFORATION MATERIAL: 1 Steel 3 Stainless steel 5 Fiberglass 8 RMP (SR) 10 Asbestos-cement 2 Brass 4 Galvanized steel 6 Concrete tile 9 ABS 11 Other (specify) 12 None used (open hole) SCREEN OR PERFORATION OPENINGS ARE: 1 Continuous slot 3 Mill slot 5 Gauzed wrapped 8 Saw cut 11 None (open hole) 2 Louvered shutter 4 Key punched 6 Wire wrapped 9 Drilled holes 10 Other (specify) SCREEN-PERFORATED INTERVALS: From 50 ft. to 62 ft. From 50 ft. to 62 ft. From 50 ft. to 62 ft. GRAVEL PACK INTERVALS: From 30 ft. to 62 ft. From 30 ft. to 62 ft. From 30 ft. to 62 ft.

6 GROUT MATERIAL: 1 Neat cement 2 Cement grout 3 Bentonite 4 Other Grout Intervals: From 3 ft. to 30 ft. From 3 ft. to 30 ft. From 3 ft. to 30 ft. What is the nearest source of possible contamination: 1 Septic tank 4 Lateral lines 7 Pit privy 10 Livestock pens 14 Abandoned water well 2 Sewer lines 5 Cess pool 8 Sewage lagoon 11 Fuel storage 15 Oil well/Gas well 3 Watertight sewer lines 6 Seepage pit 9 Feedyard 12 Fertilizer storage 16 Other (specify below) 13 Insecticide storage Direction from well? East How many feet? 30

7 CONTRACTOR'S OR LANDOWNER'S CERTIFICATION: This water well was (1) constructed (2) reconstructed, or (3) plugged under my jurisdiction and was completed on (mo/day/year) 3-18-97 and this record is true to the best of my knowledge and belief. Kansas Water Well Contractor's License No. 611 This Water Well Record was completed on (mo/day/yr) 3-24-97 under the business name of Chesbury by (signature) Paul Che

INSTRUCTIONS: Use typewriter or ball point pen. PLEASE PRESS FIRMLY and PRINT clearly. Please fill in blanks, underline or circle the correct answers. Send top three copies to Kansas Department of Health and Environment, Bureau of Water, Topeka, Kansas 66620-0001. Telephone: 913-296-5545. Send one to WATER WELL OWNER and retain one for your records.