


| | | | | |
|--|---|----------------------------|----------------------------------|---------------------------------|
| 1 LOCATION OF WATER WELL: Sedgwick | FRACTION SE 1/4 NE 1/4 SW 1/4 | Section Number 3 | Township Number T 27 S | Range Number R 1W E/W |
|--|---|----------------------------|----------------------------------|---------------------------------|

Distance and direction from nearest town or city street address of well if located within city?

North Shore Blvd. West side Wichita, Kansas

| | |
|---|--|
| WATER WELL OWNER: CITY OF WICHITA | Board of Agriculture, Division of Water Resource |
| RR#, ST. ADDRESS, BOX #: 455 N. Main | Application Number: 960436 |
| CITY, STATE, ZIP CODE: Wichita, Kansas 67203 | |

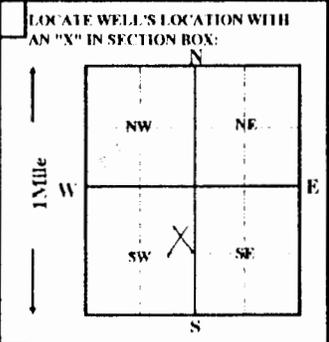

| | | | | | | | |
|---|------------------------------|------------------------------------|---------------------------------|---------------------------|---------------------------------|-----|--|
| 4 DEPTH OF COMPOSITE WELL | 45 | ft. | ELEVATION: | | | | |
| Depth(s) groundwater Encountered | 1 | ft. | 2 | ft. | 3 | ft. | |
| WELL'S STATIC WATER LEVEL | 10 | FT. BELOW LAND SURFACE MEASURED ON | 06/03/1997 | | | | |
| Pump test data: | Well water was | ft. after | hours pumping | gpm | | | |
| Est. Yield | gpm: Well water was | ft. after | hours pumping | gpm | | | |
| Bore Hole Diameter | in. to | ft. and | in. to | ft. | | | |
| WELL WATER TO BE USED AS: | 5 Public water supply | 8 Air conditioning | 11 Injection well | | | | |
| | 1 Domestic | 3 Feedlot | 6 Oil field water supply | 9 Dewatering | 12 Other (Specify below) | | |
| | 2 Irrigation | 4 Industrial | 7 Lawn and garden only | 10 Monitoring well | | | |
| Was a chemical/bacteriological sample submitted to Department? Yes <input type="checkbox"/> No <input checked="" type="checkbox"/> ; If yes, mo/day/yr sample was submitted | | | | | | | |
| Water Well Disinfected? Yes <input checked="" type="checkbox"/> No <input type="checkbox"/> | | | | | | | |

| | | | | | |
|---|--------------------|-------------------|-------------------------|-----------------------------|---------------------|
| 5 TYPE OF CASING USED: | 5 Wrought iron | 8 Concrete tile | CASING JOINTS: | Glued | Clamped |
| 1 Steel | 3 RMP (SR) | 6 Asbestos-Cement | 9 Other (Specify below) | Welded | |
| 2 PVC | 4 ABS | 7 Fiberglass | | Threaded | |
| Blank casing Diameter | 8 in. to | ft., Dia | in. to | ft., Dia | in. to |
| Casing height above land surface | 36 in., | weight | lbs. / ft. | Wall thickness or gauge No. | |
| TYPE OF SCREEN OR PERFORATION MATERIAL: | | | 7 PVC | 10 Asbestos-cement | |
| 1 Steel | 3 Stainless Steel | 5 Fiberglass | 8 RMP (SR) | 11 other (specify) | N/A |
| 2 Brass | 4 Galvanized steel | 6 Concrete tile | 9 ABS | 12 None used (open hole) | |
| SCREEN OR PERFORATION OPENING ARE: | | | 5 Gauzed wrapped | 8 Saw cut | 11 None (open hole) |
| 1 Continuous slot | 3 Mill slot | 6 Wire wrapped | 9 Drilled holes | | |
| 2 Louvered shutter | 4 Key punched | 7 Torch cut | 10 Other (specify) | N/A | |
| SCREEN-PERFORATION INTERVALS: | | | from | ft. to | ft., From |
| GRAVEL PACK INTERVALS: | | | from | ft. to | ft., From |
| | | | from | ft. to | ft., From |
| | | | from | ft. to | ft., From |

| | | | | |
|---|-----------------|-------------------|-----------------------|--------------------------|
| 6 GROUT MATERIAL: | 1 Neat cement | 2 Cement grout | 3 Bentonite | 4 Other |
| Grout Intervals: From | 3 ft. to | 6 ft. From | ft. to | ft. From |
| What is the nearest source of possible contamination: | | | | |
| 1 Septic tank | 4 Lateral lines | 7 Pit privy | 10 Livestock pens | 14 Abandon water well |
| 2 Sewer lines | 5 Cess pool | 8 Sewage lagoon | 11 Fuel storage | 15 Oil well/Gas well |
| 3 Watertight sewer lines | 6 Seepage pit | 9 Feedyard | 12 Fertilizer storage | 16 Other (specify below) |
| | | | | None Apparent |

| Direction from well? | | How many feet? | | | | |
|----------------------|----|----------------|--|-----------|-----------|------------------------------------|
| FROM | TO | LITHOLOGIC LOG | | FROM | TO | PLUGGING INTERVALS |
| | | | | 0 | 3 | surface clay and silt |
| | | | | 3 | 6 | cement grout |
| | | | | 6 | 10 | bentonite hole plug |
| | | | | 10 | 45 | chlorinated sand and gravel |

7 CONTRACTOR'S OR LANDOWNER'S CERTIFICATION: This water well was (1) constructed, (2) reconstructed, or (3) plugged under my jurisdiction and was completed on (mo/day/year) **06/03/1997** and this record is true to the best of my knowledge and belief. Kansas Water Well Contractor's License No. **236** This Water Well Record was completed on (mo/day/yr) **06/04/97** Under the business name of **Harp Well & Pump Service, Inc** by (signature) *Todd S. Harp*