

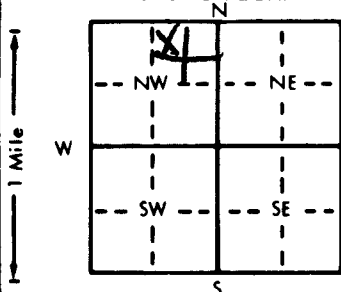
1 LOCATION OF WATER WELL: County: <u>Sedgewick</u> Fraction <u>NW</u> $\frac{1}{4}$ <u>NE</u> $\frac{1}{4}$ <u>NW</u> $\frac{1}{4}$ Section Number <u>13</u> Township Number <u>T 27 S</u> Range Number <u>R 1</u> <u>EW</u>

Distance and direction from nearest town or city street address of well if located within city?

1200 n High

2 WATER WELL OWNER: RR#, St. Address, Box # : <u>1200 n High</u> City, State, ZIP Code : <u>Wichita KS</u>	Board of Agriculture, Division of Water Resources Application Number: <u>none</u>
--	--

3 LOCATE WELL'S LOCATION WITH AN "X" IN SECTION BOX:	4 DEPTH OF COMPLETED WELL: <u>35</u> ft. ELEVATION: <u>1300</u>
--	---

Depth(s) Groundwater Encountered 1. 15 ft. 2. 15 ft. 3. 15 ft.WELL'S STATIC WATER LEVEL 15 ft. below land surface measured on mo/day/yr 12-17-98

Pump test data: Well water was _____ ft. after _____ hours pumping _____ gpm

Est. Yield _____ gpm: Well water was _____ ft. after _____ hours pumping _____ gpm

Bore Hole Diameter 9 in. to 15 ft. and _____ in. to _____ ft.

WELL WATER TO BE USED AS: 5 Public water supply 8 Air conditioning 11 Injection well

1 Domestic 3 Feedlot 6 Oil field water supply 9 Dewatering 12 Other (Specify below)

2 Irrigation 4 Industrial 7 Lawn and garden only 10 Monitoring wellWas a chemical/bacteriological sample submitted to Department? Yes _____ No X; If yes, mo/day/yr sample was submitted _____Water Well Disinfected? Yes _____ No X

5 TYPE OF BLANK CASING USED:	5 Wrought iron	8 Concrete tile	CASING JOINTS: Glued <u>X</u> Clamped
------------------------------	----------------	-----------------	---------------------------------------

1 Steel 3 RMP (SR) 6 Asbestos-Cement 9 Other (specify below) Welded

3 PVC 4 ABS 25 Fiberglass ThreadedBlank casing diameter 5 in. to 25 ft. Dia _____ in. to _____ ft. Dia _____ in. to _____ ft.Casing height above land surface 12 in. weight _____ lbs./ft. Wall thickness or gauge No. 160TYPE OF SCREEN OR PERFORATION MATERIAL: 7 PVC 10 Asbestos-cement

1 Steel 3 Stainless steel 5 Fiberglass 8 RMP (SR) 11 Other (specify)

2 Brass 4 Galvanized steel 6 Concrete tile 9 ABS 12 None used (open hole)

SCREEN OR PERFORATION OPENINGS ARE: 5 Gauzed wrapped 8 Saw cut 11 None (open hole)

1 Continuous slot 3 Mill slot 6 Wire wrapped 9 Drilled holes

2 Louvered shutter 4 Key punched 25 7 Torch cut 35 10 Other (specify)

SCREEN-PERFORATED INTERVALS: From _____ ft. to _____ ft. From _____ ft. to _____ ft.

From _____ ft. to _____ ft. From _____ ft. to _____ ft.

GRAVEL PACK INTERVALS: From _____ ft. to _____ ft. From _____ ft. to _____ ft.

From _____ ft. to _____ ft. From _____ ft. to _____ ft.

6 GROUT MATERIAL:	1 Neat cement	2 Cement grout	3 Bentonite	4 Other
-------------------	---------------	----------------	-------------	---------

Grout Intervals: From 0 ft. to 15 ft. From _____ ft. to _____ ft. From _____ ft. to _____ ft.

What is the nearest source of possible contamination:

1 Septic tank 4 Lateral lines 7 Pit privy 10 Livestock pens 14 Abandoned water well

2 Sewer lines 5 Cess pool 8 Sewage lagoon 11 Fuel storage 15 Oil well/Gas well

3 Watertight sewer lines 6 Seepage pit 9 Feedyard 12 Fertilizer storage 16 Other (specify below)Direction from well? north How many feet? 12

FROM	TO	LITHOLOGIC LOG	FROM	TO	PLUGGING INTERVALS
------	----	----------------	------	----	--------------------

<u>0</u>	<u>8</u>	<u>Top Soil</u>			
----------	----------	-----------------	--	--	--

<u>8</u>	<u>21</u>	<u>Fine Tan Sand</u>			
----------	-----------	----------------------	--	--	--

<u>21</u>	<u>35</u>	<u>Coarse Tan Sand</u>			
-----------	-----------	------------------------	--	--	--

7 CONTRACTOR'S OR LANDOWNER'S CERTIFICATION: This water well was <u>(1)</u> constructed, (2) reconstructed, or (3) plugged under my jurisdiction and was completed on (mo/day/year) <u>12-17-98</u> and this record is true to the best of my knowledge and belief. Kansas
--

Water Well Contractor's License No. 472 This Water Well Record was completed on (mo/day/yr) 12-17-98under the business name of Beardan Pump & Well by (signature) David Beard