


<b>1</b> LOCATION OF WATER WELL: <b>Sedgwick</b>	FRACTION <b>SE 1/4 SE 1/4 NE 1/4</b>	Section Number <b>14</b>	Township Number <b>T 27 S</b>	Range Number <b>R 1W E/W</b>
---	---	-----------------------------	----------------------------------	---------------------------------

Distance and direction from nearest town or city street address of well if located within city?  
**4121 Edminister Wichita, Kansas**

WATER WELL OWNER: **KNOBLAUCH, Mary**  
 RR#, ST. ADDRESS, BOX #: **4121 Edminister**  
 CITY, STATE, ZIP CODE: **Wichita, Kansas**

Board of Agriculture, Division of Water Resource  
Application Number:

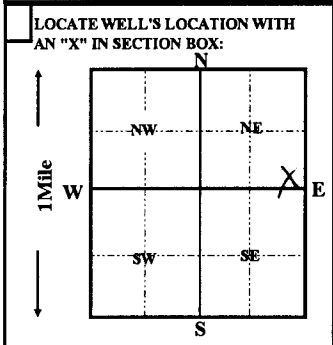

**4** DEPTH OF COMPLETED WELL **40** ft. ELEVATION:  
 Depth(s) groundwater Encountered **1** ft. **2** ft. **3** ft.  
 WELL'S STATIC WATER LEVEL **15** FT. BELOW LAND SURFACE MEASURED ON **mo/day/yr 04/10/1999**  
 Pump test data: Well water was **ft. after hours pumping gpm**  
 Est. Yield **gpm:** Well water was **ft. after hours pumping gpm**  
 Bore Hole Diameter **12** in. to **40** ft. and in. to ft.  
 WELL WATER TO BE USED AS:  
**5 Public water supply** **8 Air conditioning** **11 Injection well**  
**1 Domestic** **3 Feedlot** **6 Oil field water supply** **9 Dewatering** **12 Other (Specify below)**  
**2 Irrigation** **4 Industrial** **7 Lawn and garden only** **10 Monitoring well**

Was a chemical/bacteriological sample submitted to Department? Yes No **X**; If yes, mo/day/yr sample was submitted Water Well Disinfected? Yes **X** No

**5** TYPE OF CASING USED:  
 1 Steel 3 RMP (SR) 5 Wrought iron 8 Concrete tile CASING JOINTS: Glued **X** Clamped  
 2 PVC 4 ABS 6 Asbestos-Cement 9 Other (Specify below) Welded  
 7 Fiberglass SDR-26 Threaded

Blank casing Diameter **5** in. to **30** ft., Dia in. to ft., Dia in. to ft.  
 Casing height above land surface **12** in., weight **2.35** lbs. / ft. Wall thickness or gauge No. **.214**

TYPE OF SCREEN OR PERFORATION MATERIAL:  
 1 Steel 3 Stainless Steel 5 Fiberglass 8 RMP (SR) 11 other (specify)  
 2 Brass 4 Galvanized steel 6 Concrete tile 9 ABS 12 None used (open hole)

SCREEN OR PERFORATION OPENING ARE:  
 1 Continuous slot 3 Mill slot 5 Gauzed wrapped 8 Saw cut 11 None (open hole)  
 2 Louvered shutter 4 Key punched 6 Wire wrapped 9 Drilled holes  
 7 Torch cut 10 Other (specify)

SCREEN-PERFORATION INTERVALS: from **30** ft. to **40** ft., From ft. to ft.  
 GRAVEL PACK INTERVALS: from **24** ft. to **40** ft., From ft. to ft.

**6** GROUT MATERIAL: 1 Neat cement 2 Cement grout 3 Bentonite 4 Other **bentonite hole plug**  
 Grout Intervals: From **4** ft. to **24** ft. From ft. to ft. From ft. to ft.  
 What is the nearest source of possible contamination:  
 1 Septic tank 4 Lateral lines 7 Pit privy 10 Livestock pens 14 Abandon water well  
 2 Sewer lines 5 Cess pool 8 Sewage lagoon 11 Fuel storage 15 Oil well/Gas well  
 3 Watertight sewer lines 6 Seepage pit 9 Feedyard 12 Fertilizer storage 16 Other (specify below)  
 13 Insecticide storage

Direction from well? **East** How many feet? **90**

FROM	TO	LITHOLOGIC LOG	FROM	TO	PLUGGING INTERVALS
0	4	topsoil			
4	10	clay			
10	20	medium sand			
20	40	medium coarse sand			

**7** CONTRACTOR'S OR LANDOWNER'S CERTIFICATION: This water well was (1) constructed, (2) reconstructed, or (3) plugged under my jurisdiction and was completed on (mo/day/year) **04/10/1999** and this record is true to the best of my knowledge and belief. Kansas Water Well Contractor's License No. **236** This Water Well Record was completed on (mo/day/yr) **04/12/99**  
 Under the business name of **Harp Well & Pump Service, Inc.** by (signature) **Todd S. Harp**