

1 LOCATION OF WATER WELL:		FRACTION		Section Number		Township Number		Range Number	
Sedgwick		NE 1/4 SW 1/4 NE 1/4		17		T 27 S		R 1W E/W	

Distance and direction from nearest town or city street address of well if located within city?

9021 Suncrest

Wichita, Kansas

WATER WELL OWNER: **TEJEDA, Rachel**

RR#, ST. ADDRESS, BOX #: 9021 Suncrest


CITY, STATE, ZIP CODE : **Wichita, Kansas**

Board of Agriculture, Division of Water Resource

Application Number:

LOCATE WELL'S LOCATION WITH AN "X" IN SECTION BOX:

4	DEPTH OF COMPLETED WELL	85	ft.	ELEVATION:	
	Depth(s) groundwater Encountered	1	ft.	2	ft.
	WELL'S STATIC WATER LEVEL	25	FT. BELOW LAND SURFACE MEASURED ON	mo/day/yr	05/08/1999

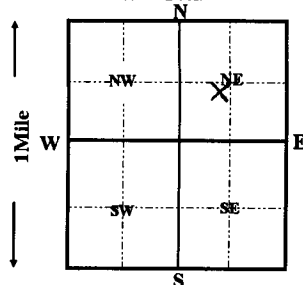

Pump test data:		Well water was		ft.	after	hours pumping	gpm
Est. Yield	gpm:	Well water was		ft.	after	hours pumping	gpm
Bore Hole Diameter	12	in.	to 85	ft.	and	in. to	ft.
WELL WATER TO BE USED AS:		5 Public water supply		8 Air conditioning		11 Injection well	
1 Domestic	3 Feedlot	6 Oil field water supply		9 Dewatering		12 Other (Specify below)	
2 Irrigation	4 Industrial	7 Lawn and garden only		10 Monitoring well			

Was a chemical/bacteriological sample submitted to Department? Yes ☐ No ☒ ; If yes, mo/day/yr sample was submitted _____

Water Well Disinfected? Yes ☐ No ☐

5	TYPE OF CASING USED:
---	----------------------

1 Steel	3 RMP (SR)
2 PVC	4 ABS

5 Wrought iron
6 Asbestos-Cement
7 Fiberglass

8 Concrete tile
9 Other (Specify below)

CASING JOINTS: Glued **X** Clamped
 Welded
 Threaded

Blank casing Diameter	5	in.	to	65	ft.	Dia	in.	to	ft.	Dia	in.	to	ft.
Casing height above land surface	12	in.				weight	2.35	lbs. / ft.		Wall thickness or gauge No.			214

TYPE OF SCREEN OR PERFORATION MATERIAL:

1 Steel
2 Brass
3 Stainless Steel
4 Galvanized steel

5 Fiberglass
6 Concrete tile

7 PVC
8 RMP (SR)
9 ABS

10 Asbestos-cement

11 other (specify)

12 None used (open hole)

SCREEN OR PERFORATION OPENING ARE:

1 Continous slot	3 Mill slot
2 Louvered shutter	4 Key punched

5 Gauzed wrapped
6 Wire wrapped
7 Torch cut

8 Saw cut
9 Drilled holes
10 Other (specify)
11 None (open hole)

SCREEN-PERFORATION INTERVALS:

from 65	ft. to 85	ft., From	ft. to	ft.
from	ft. to	ft., From	ft. to	ft.
from 24	ft. to 85	ft., From	ft. to	ft.
from	ft. to	ft., From	ft. to	ft.

6	GROUT MATERIAL:	1 Neat cement
---	-----------------	---------------

2 Cement grout

3 Bentonite

4 Other bentonite hole plug

Grout Intervals: From 4 ft. to 24
What is the nearest source of possible contamination:

1 Septic tank	4 Lateral lines
2 Sewer lines	5 Cess pool
3 Watertight sewer lines	6 Seepage pit

7 Pit privy
8 Sewage lagoon
9 Feedyard

10 Livestock pens	14 Abandon water well
11 Fuel storage	15 Oil well/Gas well
12 Fertilizer storage	16 Other (specify below)
13 Insecticide storage	

Direction from well? South

How many feet? 80

[illegible]

7 CONTRACTOR'S OR LANDOWNER'S CERTIFICATION: This water well was (1) constructed, (2) reconstructed, or (3) plugged under my jurisdiction and was completed on (mo/day/year) 05/08/1999 and this record is true to the best of my knowledge and belief. Kansas Water Well Contractor's License No. 236 This Water Well Record was completed on (mo/day/yr) 05/10/99 Under the business name of Harp Well & Pump Service, Inc. by (signature)

Todd S. Harp