


1 LOCATION OF WATER WELL: County: Shawnee, Fraction: SW 1/4 NW 1/4 SW 1/4, Section Number: 13, Township Number: T 27 S, Range Number: R 1 E/W

Distance and direction from nearest town or city street address of well if located within city? 802 N. West St Wichita, KS

2 WATER WELL OWNER: One Stop Corp, RR#, St. Address, Box #: 802 N. West, City, State, ZIP Code: Wichita, KS, Board of Agriculture, Division of Water Resources, Application Number: MW 9 1310.27

3 LOCATE WELL'S LOCATION WITH AN "X" IN SECTION BOX:

4 DEPTH OF COMPLETED WELL: 25 ft. ELEVATION: 1310.27

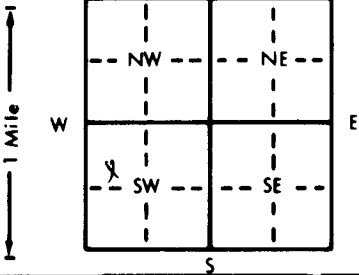

Depth(s) Groundwater Encountered: 1. 1294.84 ft. 2. ft. 3. ft. WELL'S STATIC WATER LEVEL: 15.43 ft. below land surface measured on mo/day/yr 12/2/99. Pump test data: Well water was ft. after hours pumping gpm. Est. Yield gpm. Well water was ft. after hours pumping gpm. Bore Hole Diameter: 8 in. to 25 ft. and in. to ft. WELL WATER TO BE USED AS: 5 Public water supply, 8 Air conditioning, 11 Injection well, 1 Domestic, 3 Feedlot, 6 Oil field water supply, 9 Dewatering, 12 Other (Specify below), 2 Irrigation, 4 Industrial, 7 Lawn and garden only, 10 Monitoring well. Was a chemical/bacteriological sample submitted to Department? Yes. No. X. If yes, mo/day/yr sample was submitted. Water Well Disinfected? Yes No

5 TYPE OF BLANK CASING USED: 1 Steel, 2 PVC, 3 RMP (SR), 4 ABS, 5 Wrought iron, 6 Asbestos-Cement, 7 Fiberglass, 8 Concrete tile, 9 Other (specify below), 10 Asbestos-cement, 11 Other (specify), 12 None used (open hole). CASING JOINTS: Glued, Clamped, Welded, Threaded.

Blank casing diameter: 2 in. to 10 ft., Dia. in. to ft., Dia. in. to ft. Casing height above land surface: Flush in., weight lbs./ft. Wall thickness or gauge No.

TYPE OF SCREEN OR PERFORATION MATERIAL: 1 Steel, 2 Brass, 3 Stainless steel, 4 Galvanized steel, 5 Fiberglass, 6 Concrete tile, 7 PVC, 8 RMP (SR), 9 ABS, 10 Asbestos-cement, 11 Other (specify), 12 None used (open hole).

SCREEN OR PERFORATION OPENINGS ARE: 1 Continuous slot, 2 Louvered shutter, 3 Mill slot, 4 Key punched, 5 Gauzed wrapped, 6 Wire wrapped, 7 Torch cut, 8 Saw cut, 9 Drilled holes, 10 Other (specify), 11 None (open hole).

SCREEN-PERFORATED INTERVALS: From 25 ft. to 18 10 ft., From ft. to ft. GRAVEL PACK INTERVALS: From 25 ft. to 14 8 ft., From ft. to ft.

6 GROUT MATERIAL: 1 Neat cement, 2 Cement grout, 3 Bentonite, 4 Other. Grout intervals: From 14 8 ft. to 1 ft., From ft. to ft., From ft. to ft.

What is the nearest source of possible contamination: 1 Septic tank, 2 Sewer lines, 3 Watertight sewer lines, 4 Lateral lines, 5 Cess pool, 6 Seepage pit, 7 Pit privy, 8 Sewage lagoon, 9 Feedyard, 10 Livestock pens, 11 Fuel storage, 12 Fertilizer storage, 13 Insecticide storage, 14 Abandoned water well, 15 Oil well/Gas well, 16 Other (specify below).

Direction from well? NW How many feet? 115

LITHOLOGIC LOG table with columns FROM, TO, LITHOLOGIC LOG, FROM, TO, PLUGGING INTERVALS. Handwritten entries: 0 to 4" Asphalt, 4" to 8' Silty clay, 8' to 25' Sand.

7 CONTRACTOR'S OR LANDOWNER'S CERTIFICATION: This water well was (1) constructed, (2) reconstructed, or (3) plugged under my jurisdiction and was completed on (mo/day/year) 12-1-99 and this record is true to the best of my knowledge and belief. Kansas Water Well Contractor's License No. 634. This Water Well Record was completed on (mo/day/yr) 12/2/99 under the business name of Shaleyan, Testes by (signature) M. Shaleyan.