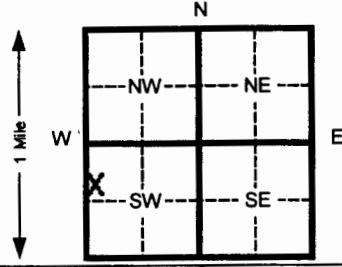


1 LOCATION OF WATER WELL:		Fraction		Section Number		Township Number		Range Number	
County: SEDGWICK		SW ¼ NW ¼ SW ¼		34		T 27 S		R 1 W	
Distance and direction from nearest town or city street address of well if located within city? 2010 AIRPORT ROAD									
2 WATER WELL OWNER: YINGLING AIRCRAFT									
RR#, St. Address, Box # : 2010 AIRPORT ROAD Board of Agriculture, Division of Water Resources									
City, State, ZIP Code : WICHITA, KS 67209 Application Number:									
3 LOCATE WELL'S LOCATION WITH AN "X" IN SECTION BOX:		4 DEPTH OF COMPLETED WELL 37.5 ft. ELEVATION:							
		Depth(s) Groundwater Encountered 1 30 ft. 2 _____ ft. 3 _____ ft. WELL'S STATIC WATER LEVEL 28.6 ft. below land surface measured on mo/day/yr 10/04/00 Pump test data: Well water was _____ Ft. after _____ hours pumping _____ gpm Est. Yield _____ Gpm: Well water was _____ Ft. after _____ Hours pumping _____ Gpm Bore Hole Diameter 8.625 in. to 37.5 ft. and _____ in. to _____ ft. WELL WATER TO BE USED AS: 5 Public water supply 8 Air conditioning 11 Injection well 1 Domestic 3 Feed lot 6 Oil field water supply 9 Dewatering 12 Other (Specify below) 2 Irrigation 4 Industrial 7 Lawn and garden (domestic) 10 Monitoring well MW-3 Was a chemical/bacteriological sample submitted to Department? Yes _____ No X If yes, mo/day/yr sample was Submitted _____ Water Well Disinfected? Yes _____ No X							
5 TYPE OF BLANK CASING USED:									
1 Steel 3 RMP (SR) 5 Wrought Iron 8 Concrete tile CASING JOINTS: Glued _____ Clamped _____ 2 PVC X 4 ABS 6 Asbestos-Cement 9 Other (specify below) _____ Welded _____ 7 Fiberglass _____ Threaded X									
Blank casing diameter 2 in. to 22.5 in. Dia _____ in. to _____ ft. Dia _____ in. to _____ ft. Casing height above land surface Flush in., weight Sch 40 Lbs./ft. Wall thickness or gauge No. _____									
TYPE OF SCREEN OR PERFORATION MATERIAL:									
1 Steel 3 Stainless steel 5 Fiberglass 8 RMP (SR) 11 Other (specify) _____ 2 Brass 4 Galvanized steel 6 Concrete tile 9 ABS 12 None used (open hole) _____									
SCREEN OR PERFORATION OPENINGS ARE:									
1 Continuous slot 3 Mill slot X 5 Gauzed wrapped 8 Saw cut 11 None (open hole) _____ 2 Louvered shutter 4 Key punched 6 Wire wrapped 9 Drilled holes 10 Other (specify) _____ 7 Torch cut									
SCREEN-PERFORATED INTERVALS: From 22.5 ft. to 37.5 ft. From _____ ft. to _____ ft. From _____ ft. to _____ ft.									
SAND PACK INTERVALS: From 21 ft. to 37.5 ft. From _____ ft. to _____ ft. From _____ ft. to _____ ft.									
6 GROUT MATERIAL:									
1 Neat cement 2 Cement grout X 3 Bentonite X 4 Other _____									
Grout Intervals From3 21 ft. to 18 ft. From2 18 ft. to 0 ft. From _____ ft. to _____ ft.									
What is the nearest source of possible contamination:									
1 Septic tank 4 Lateral lines 7 Pit privy 10 Livestock pens 14 Abandoned water well 2 Sewer lines 5 Cess pool 8 Sewage lagoon 11 Fuel storage 15 Oil well/ Gas well 3 Watertight sewer lines 6 Seepage pit 9 Feedyard 12 Fertilizer storage 16 Other (specify below) Contaminated Site 13 Insecticide storage									
Direction from well? _____ How many feet? _____									
FROM TO CODE LITHOLOGIC LOG FROM TO PLUGGING INTERVALS									
0 .5 CONCRETE									
.5 9.5 CLAY W SOME SILT									
9.5 14 SILT W SOME SAND									
14 37.5 SILTY SAND									
37.5 TD END OF BOREHOLE									
7 CONTRACTOR'S OR LANDOWNER'S CERTIFICATION: This water well was (x) constructed, (2) reconstructed, or (3) plugged under my jurisdiction and w									
Completed on (mo/day/yr) 10/04/00 and this record is true to the best of my knowledge and belief. Kansas									
Water Well Contractor's License No. 585 This Water Well Record was completed on (mo/day/yr) 10/09/00									
under the business name of Associated Environmental, Inc. By (signature) Darin R Duncan									
INSTRUCTIONS: Please fill in blanks and circle the correct answers. Send three copies to Kansas Department of Health and Environment, Bureau of Water, Topeka, Kansas 66620-0001. Telephone: 913-296-5545. Send one to WATER WELL OWNER and retain one for your records.									