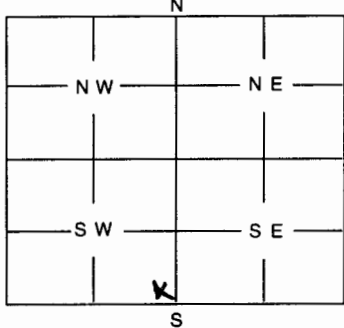


No Tag

1	LOCATION OF WATER WELL: County: <u>Sedgwick</u>	Fraction <u>SE 1/4 SE 1/4 SW 1/4</u>	Section <u>25</u>	Number	Township <u>27S</u>	Number	Range <u>1W</u>	Number																											
Distance and direction from nearest town or city street address of well if located within city? <u>ANR Freight System 3402 W. Harry, Wichita, KS</u>																																			
2	WATER WELL OWNER: <u>David Klimut</u> RR #, St. Address, Box #: <u>3402 W. Harry</u> City, State, ZIP Code: <u>Wichita, KS 67217</u>		M.W. <u>2</u> Board of Agriculture, Division of Water Resources Application Number:																																
3	MARK WELL'S LOCATION WITH AN "X" IN SECTION BOX: 		4	DEPTH OF WELL <u>18</u> ft. WELL'S STATIC WATER LEVEL <u>13</u> ft. WELL WAS USED AS: 1 Domestic 2 Irrigation 3 Feedlot 4 Industrial 5 Public Water Supply 6 Oil Field Water Supply 7 Domestic (Lawn & Garden) 8 Air Conditioning 9 Dewatering <u>10 Monitoring Well</u> 11 Injection Well 12 Other Was a chemical / bacteriological sample submitted to Department? Yes No <u>X</u> If yes, mo/day/yr sample was submitted Water Well Disinfected: Yes No <u>X</u>																															
5	TYPE OF BLANK CASING USED: 1 Steel <u>2 PVC</u> 3 RMP (SR) 4 ABS 5 Wrought 6 Asbestos-Cement 7 Fiberglass 8 Concrete Tile 9 Other (Specify below) Blank casing diameter <u>2</u> in. Was casing pulled? Yes <u>X</u> No If yes, how much <u>18"</u> Casing height above or below land surface in.																																		
6	GROUT PLUG MATERIAL: 1 Neat cement <u>2 Cement grout</u> 3 Bentonite 4 Other Grout Plug Intervals: From ft. to ft., From ft. to ft., From to ft. What is the nearest source of possible contamination: 1 Septic tank 2 Sewer lines 3 Watertight sewer lines 4 Lateral lines 5 Cess Pool 6 Seepage pit 7 Pit privy 8 Sewage lagoon 9 Feedyard 10 Livestock pens 11 Fuel storage 12 Fertilizer storage 13 Insecticide storage <u>14 Abandoned water well</u> 15 Oil well/Gas well 16 Other (specify below) Direction from well? How many feet?																																		
<table border="1" style="width:100%; border-collapse: collapse;"> <thead> <tr> <th style="width:10%;">FROM</th> <th style="width:10%;">TO</th> <th style="width:80%;">PLUGGING MATERIALS</th> </tr> </thead> <tbody> <tr> <td style="text-align: center;">18</td> <td style="text-align: center;">3</td> <td style="text-align: center;">Grout/Bentonite</td> </tr> <tr> <td style="text-align: center;">3</td> <td style="text-align: center;">0</td> <td style="text-align: center;">Concrete</td> </tr> <tr><td> </td><td> </td><td> </td></tr> <tr><td> </td><td> </td><td> </td></tr> <tr><td> </td><td> </td><td> </td></tr> <tr><td> </td><td> </td><td> </td></tr> <tr><td> </td><td> </td><td> </td></tr> <tr><td> </td><td> </td><td> </td></tr> </tbody> </table>									FROM	TO	PLUGGING MATERIALS	18	3	Grout/Bentonite	3	0	Concrete																		
FROM	TO	PLUGGING MATERIALS																																	
18	3	Grout/Bentonite																																	
3	0	Concrete																																	
7	CONTRACTOR'S OR LANDOWNER'S CERTIFICATION: This water well was plugged under my jurisdiction and was completed on (mo/day/year) <u>12/13/00</u> and this record is true to the best of my knowledge and belief. Kansas Water Well Contractor's License No. <u>6014</u> This Water Well Record was completed on (mo/day/year) by (signature) <u>William Stafford</u> under the business name of <u>Maxim Technologies</u>																																		
INSTRUCTIONS: Use typewriter or ball point pen. Please press firmly and print clearly. Please fill in blanks, underline or circle the correct answers. Send top three copies to Kansas Department of Health and Environment, Bureau of Water, Topeka, Kansas 66620-0001. Telephone: 785/296-3565. Send one to Water Well Owner and retain one for your records.																																			