CORRECTION TO WATER WELL RECORD (WWC-5)

The following correction(s) was made to the attached WWC-5 log, in order to file the item or to rectify lacking or incorrect information.

Fraction (1/4 1/4 1/4) Section-Township-Range changed:

listed as No legal description given

changed to SE NE SW, 12-27S-1W

Other changes: Initial statements: _____

Changed to: _____

Comments: _____

verification method: Well address on form, Wichita city map, and Wichita West 1:24,000 topo. map. initials: DRL date: 3/20/2001

submitted by: Kansas Geological Survey, Data Resources Library, 1930 Constant Ave., Lawrence, KS 66047-3726
to: Kansas Dept of Health & Environment Bureau of Water Industrial Programs, Bldg 283, Forbes Field, KS 66620

WATER WELL PLUGGING RECORD ✓ Form WWC-5P ✓ KSA 82a-1212 ✓ ✓

1 LOCATION OF WATER WELL:	Fraction	Section Number	Township Number	Range Number
County: Sedgwick	1/4 1/4 1/4			

Distance and direction from nearest town or city street address of well if located within city?
1525 N. Gow St.

2 WATER WELL OWNER: Joe & Kelly Dunegan
RR#, St. Address, Box #: 1525 N. Gow St.
City, State, ZIP Code : Wichita, KS 67203
Board of Agriculture, Division of Water Resources Application Number:

3 MARK WELL'S LOCATION WITH AN "X" IN SECTION BOX:

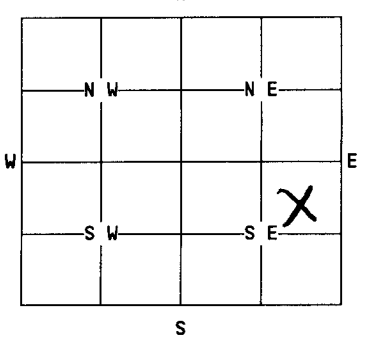

4 DEPTH OF WELL.....30.....ft.
WELL'S STATIC WATER LEVEL...17.....ft.
WELL WAS USED AS:

1 Domestic	5 Public Water Supply	9 Dewatering
2 Irrigation	6 Oil Field Water Supply	10 Monitoring Well
3 Feedlot	7 Lawn and Garden Only	11 Injection Well
4 Industrial	8 Air Conditioning	12 Other.....

Was a chemical/bacteriological sample submitted to Department? Yes....No..X..
If yes, mo/day/yr sample was submitted.....
Water Well Disinfected: Yes..X.. No.....

5 TYPE OF BLANK CASING USED:

1 Steel	3 RMP (SR)	5 Wrought	7 Fiberglass	9 Other (specify below)
2 PVC	4 ABS	6 Asbestos-Cement	8 Concrete Tile	.....

Blank casing diameter...1½...in. Was casing pulled? Yes..N/A.. No..X.. If yes, how much.....
Casing height above or below land surface...3ft...below...in.

6 GROUT PLUG MATERIAL: 1 Neat cement 2 Cement grout 3 Bentonite 4 Other.....

Grout Plug Intervals: From..30..ft. to.....ft., From.....ft. to .....ft., From..... to.....ft.
→ Bsmt Floor

What is the nearest source of possible contamination:

1 Septic tank	6 Seepage pit	11 Fuel storage	16 Other (specify below) ✓
2 Sewer lines	7 Pit privy	12 Fertilizer storage	.....
3 Watertight sewer lines	8 Sewage lagoon	13 Insecticide storage	
4 Lateral lines	9 Feedyard	14 Abandoned water well	
5 Cess Pool	10 Livestock pens	15 Oil well/Gas well	

Direction from well? ..... How many feet? .....

FROM	TO	PLUGGING MATERIALS
30	Bsmt Floor	Cement Grout

B

7 CONTRACTOR'S OR LANDOWNER'S CERTIFICATION: This water well was plugged under my jurisdiction and was completed on (mo/day/year)...11-8-97... and this record is true to the best of my knowledge and belief. Kansas Water Well Contractor's License No. ...N/A... This Water Well Record was completed on (mo/day/year) ..... under the business name of ...Self/OWNER... by (signature) ...Joe Dunegan... Joe Dunegan

INSTRUCTIONS: Use typewriter or ball point pen. Please press firmly and print clearly. Please fill in blanks, underline or circle the correct answers. Send top three copies to Kansas Department of Health and Environment, Bureau of Water, Topeka, Kansas 66620-0001. Telephone: 913/296-3565. Send one to Water Well Owner and retain one for your records.