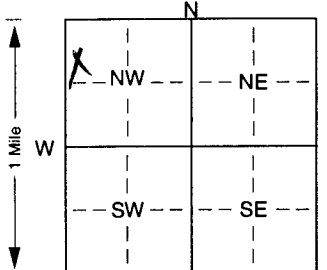


6AS

1 LOCATION OF WATER WELL:		Fraction		Section Number		Township Number		Range Number	
County: Sedgwick		SW 1/4 NW 1/4 NW 1/4		25		T 27 S		R 1 EW	
Distance and direction from nearest town or city street address of well if located within city? University & West Street, Wichita KS									
2 WATER WELL OWNER: Coastal mart									
RR#, St. Address, Box # : 909 Greenway Plaza					Board of Agriculture, Division of Water Resources				
City, State, ZIP Code : Houston, TX 77040					Application Number:				
3 LOCATE WELL'S LOCATION WITH AN "X" IN SECTION BOX:			4 DEPTH OF COMPLETED WELL: 32.0 ft.			ELEVATION:			
			Depth(s) Groundwater Encountered 1. 16.0 ft. 2. 32.0 ft. 3. 10-18-01 ft.			WELL'S STATIC WATER LEVEL 16.0 ft. below land surface measured on mo/day/yr 10-18-01			
			Pump test data: Well water was ... ft. after ... hours pumping ... gpm						
			Est. Yield ... gpm: Well water was ... ft. after ... hours pumping ... gpm						
			Bore Hole Diameter: 8.5 in. to 32.0 ft., and ... in. to ... ft.						
			WELL WATER TO BE USED AS: 5 Public water supply 8 Air conditioning 11 Injection well						
			1 Domestic 3 Feedlot 6 Oil field water supply 9 Dewatering 12 Other (Specify below)						
			2 Irrigation 4 Industrial 7 Domestic (lawn & garden) 10 Monitoring well			AS			
			Was a chemical/bacteriological sample submitted to Department? Yes. ... No. X ... If yes, mo/day/yr sample was submitted			Water Well Disinfected? Yes ... No X			
5 TYPE OF BLANK CASING USED:									
1 Steel 3 RMP (SR) 6 Asbestos-Cement 9 Other (specify below) Casing Joints: Glued. ... Clamped. ...									
2 PVC 4 ABS 7 Fiberglass ... Welded. ... Threaded. flush									
Blank casing diameter 2 in. to 22.0 ft., Dia. ... in. to ... ft., Dia. ... in. to ... ft., Dia. ...									
Casing height above land surface flush in., weight 70.2 lbs./ft. Wall thickness or gauge No. Sch. 40									
TYPE OF SCREEN OR PERFORATION MATERIAL:									
1 Steel 3 Stainless steel 5 Fiberglass 7 PVC 10 Asbestos-cement									
2 Brass 4 Galvanized steel 6 Concrete tile 8 RMP (SR) 11 Other (specify) ...									
12 None used (open hole)									
SCREEN OR PERFORATION OPENINGS ARE:									
1 Continuous slot 3 Mill slot 5 Gauzed wrapped 8 Saw cut 11 None (open hole)									
2 Louvered shutter 4 Key punched 6 Wire wrapped 9 Drilled holes									
7 Torch cut 10 Other (specify) ... ft.									
SCREEN-PERFORATED INTERVALS: From 22.0 ft. to 32.0 ft. From ... ft. to ... ft.									
GRAVEL PACK INTERVALS: From 20.0 ft. to 32.0 ft. From ... ft. to ... ft.									
6 GROUT MATERIAL: 1 Neat cement 2 Cement grout 3 Bentonite 4 Other ...									
Grout Intervals: From 2 ft. to 20.0 ft., From ... ft. to ... ft., From ... ft. to ... ft.									
What is the nearest source of possible contamination:									
1 Septic tank 4 Lateral lines 7 Pit privy 10 Livestock pens 14 Abandoned water well									
2 Sewer lines 5 Cess pool 8 Sewage lagoon 11 Fuel storage 15 Oil well/Gas well									
3 Watertight sewer lines 6 Seepage pit 9 Feedyard 12 Fertilizer storage 16 Other (specify below)									
13 Insecticide storage									
Direction from well? How many feet?									
FROM TO LITHOLOGIC LOG FROM TO PLUGGING INTERVALS									
0 2 Clay, with sand									
2 32 Sand, Fine to coarse									
7 CONTRACTOR'S OR LANDOWNER'S CERTIFICATION: This water well was (1) constructed, (2) reconstructed, or (3) plugged under my jurisdiction and was completed on (mo/day/year) 10-18-01 and this record is true to the best of my knowledge and belief. Kansas Water Well Contractor's Licence No. 531 This Water Well Record was completed on (mo/day/yr) 11-9-01 under the business name of Geotechnical Services Inc. by (signature) Gellner Schmidt									
INSTRUCTIONS: Use typewriter or ball point pen. PLEASE PRESS FIRMLY and PRINT clearly. Please fill in blanks, underline or circle the correct answers. Send top three copies to Kansas Department of Health and Environment, Bureau of Water, Topeka, Kansas 66620-0001. Telephone 785-296-5524. Send one to WATER WELL OWNER and retain one for your records. Fee of \$5.00 for each constructed well.									