

1 LOCATION OF WATER WELL: Fraction $\frac{1}{4}$ $\frac{1}{4}$ $\frac{1}{4}$ Section Number 19 Township Number T 27 S Range Number R 1 E

Distance and direction from nearest town or city street address of well if located within city?


2 WATER WELL OWNER: Randy Esterline

RR#, St. Address, Box #: 1114 Sherrill
City, State, ZIP Code: Wichita, KS 67209

Board of Agriculture, Division of Water Resources
Application Number:

3 LOCATE WELL'S LOCATION WITH 4 DEPTH OF COMPLETED WELL: 75 ft. ELEVATION:

AN "X" IN SECTION BOX:

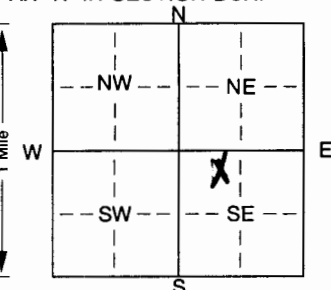

Depth(s) Groundwater Encountered 1. ft. 2. ft. 3. ft.
WELL'S STATIC WATER LEVEL 20 ft. below land surface measured on mo/day/yr 12-3-01
Pump test data: Well water was . ft. after . hours pumping . gpm
Est. Yield 25 gpm: Well water was . ft. after . hours pumping . gpm
Bore Hole Diameter . 11 in. to 75 ft., and . in. to . ft.
WELL WATER TO BE USED AS: 5 Public water supply 8 Air conditioning 11 Injection well
1 Domestic 3 Feedlot 9 Oil field water supply 9 Dewatering 12 Other (Specify below)
2 Irrigation 4 Industrial 7 Domestic (lawn & garden) 10 Monitoring well

Was a chemical/bacteriological sample submitted to Department? Yes. . No. . X If yes, mo/day/yr sample was submitted
Water Well Disinfected? Yes X No

5 TYPE OF BLANK CASING USED:

1 Steel 3 RMP (SR) 5 Wrought iron 8 Concrete tile CASING JOINTS: Glued X Clamped .
2 PVC 4 ABS 6 Asbestos-Cement 9 Other (specify below) Welded .
7 Fiberglass Threaded .

Blank casing diameter 5 in. to 63 ft. Dia . in. to . ft. Dia . in. to . ft.
Casing height above land surface . 12 in., weight 240 lbs./ft. Wall thickness or gauge No. 16 gpsi

TYPE OF SCREEN OR PERFORATION MATERIAL:

1 Steel 3 Stainless steel 5 Fiberglass 7 PVC 10 Asbestos-cement
2 Brass 4 Galvanized steel 6 Concrete tile 8 RMP (SR) 11 Other (specify)
12 None used (open hole)

SCREEN OR PERFORATION OPENINGS ARE:

1 Continuous slot 3 Mill slot 5 Gauzed wrapped 8 Saw cut 11 None (open hole)
2 Louvered shutter 4 Key punched 6 Wire wrapped 9 Drilled holes
7 Torch cut 10 Other (specify) . ft.

SCREEN-PERFORATED INTERVALS: From . ft. to . ft., From . ft. to . ft.
From . ft. to . ft., From . ft. to . ft.

GRAVEL PACK INTERVALS: From . 20 ft. to . 75 ft., From . ft. to . ft.
From . ft. to . ft., From . ft. to . ft.

6 GROUT MATERIAL: 1 Neat cement 2 Cement grout 3 Bentonite 4 Other .
Grout Intervals: From . 3 ft. to . 20 ft., From . ft. to . ft., From . ft. to . ft.

What is the nearest source of possible contamination:

1 Septic tank 4 Lateral lines 7 Pit privy 10 Livestock pens 14 Abandoned water well
2 Sewer lines 5 Cess pool 8 Sewage lagoon 11 Fuel storage 15 Oil well/Gas well
3 Watertight sewer lines 6 Seepage pit 9 Feedyard 12 Fertilizer storage 16 Other (specify below)
Direction from well? north How many feet? 30

FROM	TO	LITHOLOGIC LOG	FROM	TO	PLUGGING INTERVALS
0	2	top soil			
2	30	clay			
30	45	fine to med sand			
45	75	clay			
75		fine sand			

7 CONTRACTOR'S OR LANDOWNER'S CERTIFICATION: This water well was (1) constructed, (2) reconstructed, or (3) plugged under my jurisdiction and was completed on (mo/day/year) 12-3-01 and this record is true to the best of my knowledge and belief. Kansas Water Well Contractor's Licence No. 318 This Water Well Record was completed on (mo/day/yr) 12-7-01 under the business name of Weninger Drilling Inc. by (signature) Michael Gorgo