WATER WELL RECORD Form WWC-5 KSA 82a-1212 ID No. _____

1 LOCATION OF WATER WELL:	Fraction	Section Number	Township Number	Range Number
County: SEDGWICK	NW ¼ SE ¼ SE ¼	15	T 27 S	R 1 E (W)

Distance and direction from nearest town or city street address of well if located within city?
5807 W. Franklin Wichita, Ks

2 WATER WELL OWNER: James Ritchey
RR#, St. Address, Box # : 5807 W. Franklin
City, State, ZIP Code : Wichita Ks 67202

Board of Agriculture, Division of Water Resources Application Number:

3 LOCATE WELL'S LOCATION WITH AN "X" IN SECTION BOX:

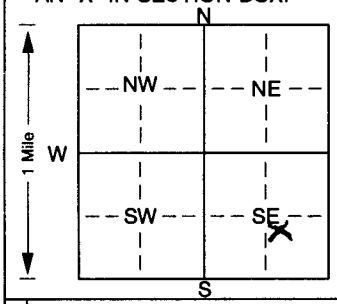

4 DEPTH OF COMPLETED WELL 33 ft. ELEVATION:
Depth(s) Groundwater Encountered 1. ft. 2. ft. 3. ft.
WELL'S STATIC WATER LEVEL 160 ft. below land surface measured on mo/day/yr
Pump test data: Well water was ft. after hours pumping gpm
Est. Yield gpm: Well water was ft. after hours pumping gpm
Bore Hole Diameter 11 1/4 in. to 33 ft., and in. to ft.
WELL WATER TO BE USED AS: 5 Public water supply 8 Air conditioning 11 Injection well
1 Domestic 3 Feedlot 6 Oil field water supply 9 Dewatering 12 Other (Specify below)
(2) Irrigation 4 Industrial 7 Domestic (lawn & garden) ~~10 Monitoring well~~
Was a chemical/bacteriological sample submitted to Department? Yes No ; If yes, mo/day/yrs sample was submitted
Water Well Disinfected? Yes — No

5 TYPE OF BLANK CASING USED: 5 Wrought iron 8 Concrete tile CASING JOINTS: Glued Clamped
1 Steel 3 RMP (SR) 6 Asbestos-Cement 9 Other (specify below) Welded
(2) PVC 4 ABS 7 Fiberglass Threaded X
Blank casing diameter 5 in. to 23 ft., Dia in. to ft., Dia in. to ft.
Casing height above land surface 12 in., weight Sch 40 lbs./ft. Wall thickness or gauge No.
TYPE OF SCREEN OR PERFORATION MATERIAL: (7) PVC 10 Asbestos-cement
1 Steel 3 Stainless steel 5 Fiberglass 8 RMP (SR) 11 Other (specify)
2 Brass 4 Galvanized steel 6 Concrete tile 9 ABS 12 None used (open hole)
SCREEN OR PERFORATION OPENINGS ARE: 5 Gauzed wrapped 8 Saw cut 11 None (open hole)
1 Continuous slot (3) Mill slot .025 6 Wire wrapped 9 Drilled holes
2 Louvered shutter 4 Key punched 7 Torch cut 10 Other (specify) ft.
SCREEN-PERFORATED INTERVALS: From 33 ft. to 23 ft., From ft. to ft.
From ft. to ft., From ft. to ft.
GRAVEL PACK INTERVALS: From 33 ft. to 19 ft., From ft. to ft.
From ft. to ft., From ft. to ft.

6 GROUT MATERIAL: 1 Neat cement (2) Cement grout (3) Bentonite 4 Other
Grout Intervals: From 14 ft. to 3 ft., From 19 ft. to 14 ft., From ft. to ft.
What is the nearest source of possible contamination: 10 Livestock pens 14 Abandoned water well
1 Septic tank 4 Lateral lines 7 Pit privy 11 Fuel storage 15 Oil well/Gas well
2 Sewer lines 5 Cess pool 8 Sewage lagoon 12 Fertilizer storage 16 Other (specify below)
(3) Watertight sewer lines 6 Seepage pit 9 Feedyard 13 Insecticide storage
Direction from well? West How many feet? 15

FROM	TO	LITHOLOGIC LOG	FROM	TO	PLUGGING INTERVALS
0	1	Grass, Top Soil			
1	4	Brn Silty Clay			
4	8	Fine Sandy loam			
8	12	Fine Brn Sand			
12	20	Fine to Medium Sand			
		wet @ 17'			
20	33	Medium Sand Coarse Increase			
		w Depth well Sorted			

7 CONTRACTOR'S OR LANDOWNER'S CERTIFICATION: This water well was (1) constructed, (2) reconstructed, or (3) plugged under my jurisdiction and was completed on (mo/day/year) 8-16-02 and this record is true to the best of my knowledge and belief. Kansas Water Well Contractor's Licence No. 575 This Water Well Record was completed on (mo/day/yr) 8-24-02 under the business name of Funkee Drilling Service Inc by (signature)

INSTRUCTIONS: Use typewriter or ball point pen. *PLEASE PRESS FIRMLY* and *PRINT* clearly. Please fill in blanks, underline or circle the correct answers. Send top three copies to Kansas Department of Health and Environment, Bureau of Water, Topeka, Kansas 66620-0001. Telephone 785-296-5524. Send one to WATER WELL OWNER and retain one for your records. Fee of $5.00 for each constructed well.