NW SW SE NW

WATER WELL PLUGGING RECORD

Form WWC-5P KSA 82a-1212

Lot 16 Sunset Hights add. Block 1

1 LOCATION OF WATER WELL:	Fraction	Section Number	Township Number	Range Number
County: Sedgwick	~~NW~~ 1/4 ~~NW~~ 1/4 ~~NW~~ 1/4	12	27	1 W

Distance and direction from nearest town or city street address of well if located within city?
1833 High

2 WATER WELL OWNER: Trella Fyler

RR#, St. Address, Box #: 1833 High
City, State, ZIP Code : Wichita KS 67203

Board of Agriculture, Division of Water Resources
Application Number:

3 MARK WELL'S LOCATION WITH AN "X" IN SECTION BOX:

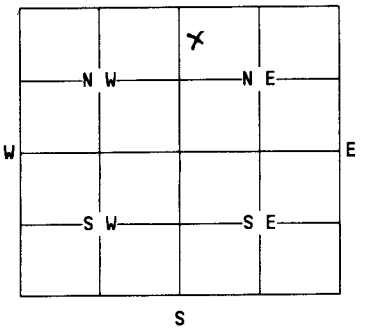

4 DEPTH OF WELL.....40.....ft.

WELL'S STATIC WATER LEVEL.....25.....ft.

WELL WAS USED AS:

1 Domestic	5 Public Water Supply	9 Dewatering
2 Irrigation	6 Oil Field Water Supply	10 Monitoring Well
3 Feedlot	(7 Lawn and Garden Only)	11 Injection Well
4 Industrial	8 Air Conditioning	12 Other.....

Was a chemical/bacteriological sample submitted to Department? Yes....No..X..
If yes, mo/day/yr sample was submitted.....

Water Well Disinfected: Yes..... No..X..

5 TYPE OF BLANK CASING USED:

(1 Steel)	3 RMP (SR)	5 Wrought	7 Fiberglass	9 Other (specify below)
2 PVC	4 ABS	6 Asbestos-Cement	8 Concrete Tile	.....

Blank casing diameter.....2.....in. Was casing pulled? Yes..... No..X.. If yes, how much.....
Casing height above or below land surface.....3 ft.....in.

6 GROUT PLUG MATERIAL: (1 Neat cement) 2 Cement grout 3 Bentonite 4 Other.....

Grout Plug Intervals: From.40.ft. to...3...ft., From.....ft. to .....ft., From..... to.....ft.

What is the nearest source of possible contamination:

1 Septic tank	6 Seepage pit	11 Fuel storage	(16 Other (specify below) Termite Treatment)
2 Sewer lines	7 Pit privy	12 Fertilizer storage	
3 Watertight sewer lines	8 Sewage lagoon	13 Insecticide storage	
4 Lateral lines	9 Feedyard	14 Abandoned water well	
5 Cess Pool	10 Livestock pens	15 Oil well/Gas well	

Direction from well? ..... How many feet? .....

FROM	TO	PLUGGING MATERIALS
40	3	Neat Cement
3	0	Compacted Soil

7 CONTRACTOR'S OR LANDOWNER'S CERTIFICATION: This water well was plugged under my jurisdiction and was completed on (mo/day/year)...4-6-2002..... and this record is true to the best of my knowledge and belief. Kansas Water Well Contractor's License No. ...na.a..... This Water Well Record was completed on (mo/day/year) ..... under the business name of .Nan A.....
by (signature) ...Nan Seamster.....

INSTRUCTIONS: Use typewriter or ball point pen. Please press firmly and print clearly. Please fill in blanks, underline or circle the correct answers. Send top three copies to Kansas Department of Health and Environment, Bureau of Water, Topeka, Kansas 66620-0001. Telephone: 785/296-3565. Send one to Water Well Owner and retain one for your records.