WATER WELL RECORD Form WWC-5 KSA 82a-1212

1 LOCATION OF WATER WELL:	Fraction	Section Number	Township Number	Range Number
County: Sedwick	SW ¼ SW ¼ SW ¼	24	T 27 S	R 1 (East)

Distance and direction from nearest town or city street address of well if located within city? WEST

2 WATER WELL OWNER: Town & Country 73

RR#, St. Address, Box # : 240 S West St

City, State, ZIP Code : Wichita, Ks 67202 AS-9

Board of Agriculture, Division of Water Resources Application Number:

3 LOCATE WELL'S LOCATON WITH AN "X" IN SECTION BOX:

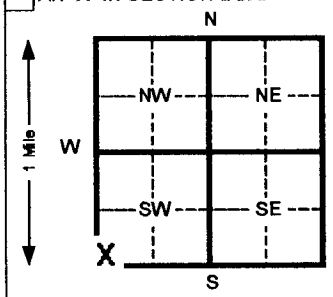

4 DEPTH OF COMPLETED WELL 29 ft. ELEVATION:

Depth(s) Groundwater Encountered 1 ft. 2 ft. 3 ft.

WELL'S STATIC WATER LEVEL 16 ft. below land surface measured on mo/day/yr

Pump test data: Well water was ft. after hours pumping gpm

Est. Yield gpm: Well water was ft. after hours pumping gpm

Bore Hole Diameter 8 in. to 29 ft. and in. to ft.

WELL WATER TO BE USED AS: 5 Public water supply 8 Air conditioning 11 Injection well
1 Domestic 3 Feed lot 6 Oil field water supply 9 Dewatering 12 Other (Specify below)
2 Irrigation 4 Industrial 7 Lawn and garden (domestic) [10] Monitoring well

Was a chemical/bacteriological sample submitted to Department? Yes No X If yes, mo/day/yr sample was submitted

Water Well Disinfected? Yes No X

5 TYPE OF BLANK CASING USED: 5 Wrought Iron 8 Concrete tile CASING JOINTS: Glued Clamped
1 Steel 3 RMP (SR) 6 Asbestos-Cement 9 Other (specify below) Welded
[2] PVC 4 ABS 7 Fiberglass Threaded X

Blank casing diameter 2 in. to 26.5 ft., Dia in. to ft., Dia in. to ft.

Casing height above land surface 0 in., weight .716 lbs./ft. Wall thickness or gauge No. .154

TYPE OF SCREEN OR PERFORATION MATERIAL: [7] PVC 10 Asbestos-cement
1 Steel 3 Stainless steel 5 Fiberglass 8 RMP (SR) 11 Other (specify)
2 Brass 4 Galvanized steel 6 Concrete tile 9 ABS 12 None used (open hole)

SCREEN OR PERFORATION OPENINGS ARE: 5 Gauzed wrapped [8] Saw cut 11 None (open hole)
1 Continuous slot 3 Mill slot 6 Wire wrapped 9 Drilled holes
2 Louvered shutter 4 Key punched 7 Torch cut 10 Other (specify)

SCREEN-PERFORATED INTERVALS: From 26.5 ft. to 29 ft. From ft. to ft.
From ft. to ft. From ft. to ft.

GRAVEL PACK INTERVALS: From 3 ft. to 29 ft. From ft. to ft.
From ft. to ft. From ft. to ft.

6 GROUT MATERIAL: 1 Neat cement [2 Cement grout] [3 Bentonite] 4 Other

Grout Intervals From 0 ft. to 2 ft. From 2 ft. to 3 ft. From ft. to ft.

What is the nearest source of possible contamination: 10 Livestock pens 14 Abandoned water well
1 Septic tank 4 Lateral lines 7 Pit privy 11 Fuel storage 15 Oil well/ Gas well
2 Sewer lines 5 Cess pool 8 Sewage lagoon 12 Fertilizer storage 16 Other (specify below)
3 Watertight sewer lines 6 Seepage pit 9 Feedyard 13 Insecticide storage Contaminated site

Direction from well? How many feet?

FROM	TO	CODE	LITHOLOGIC LOG	FROM	TO	PLUGGING INTERVALS
0	.5		Asphalt			
.5	2		Dark gray silt fill			
2	5		Silty clay, moist			
5	8		Silty clay w/some limestone			
			Fragments, moist			
8	14.5		Fine grained sand, scattered			
			Gravel			
14.5	20		Grading to gray sand & gravel			
20	29		Sand & gravel			

7 CONTRACTOR'S OR LANDOWNER'S CERTIFICATION: This water well was (1) constructed, (2) reconstructed, or (3) plugged under my jurisdiction and was completed on (mo/day/yr) 3-19-02 and this record is true to the best of my knowledge and belief. Kansas Water Well Contractor's License No. 554 This Water Well Record was completed on (mo/day/yr) 5-9-02 under the business name of Woofter Pump and Well Inc. by (signature) [signature]

INSTRUCTIONS:. Please fill in blanks and circle the correct answers. Send three copies to Kansas Department of Health and Environment, Bureau of Water, Topeka, Kansas 66620-0001. Telephone: 913-296-5545. Send one to WATER WELL OWNER and retain one for your records.

OFFICE USE ONLY T R SEC

Form provided by Farmo On A Disk, Inc., Dallas, Texas (214) 840-8400