WATER WELL RECORD Form WWC-5 KSA 82a-1212 ID No. _____

1 LOCATION OF WATER WELL:	Fraction	Section Number	Township Number	Range Number
County: Sedgwick	SW ¼ NW ¼ NE ¼	6	T 27 S	R 1 E/W

Distance and direction from nearest town or city street address of well if located within city?
11817 W. 5th Central Park at Wichita KS

2 WATER WELL OWNER: Chris Friend
RR#, St. Address, Box # : 11817 W 5th Central Park
City, State, ZIP Code : Wichita KS

Board of Agriculture, Division of Water Resources
Application Number:

3 LOCATE WELL'S LOCATION WITH AN "X" IN SECTION BOX:

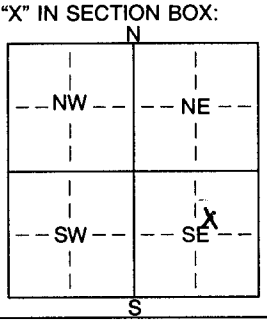

4 DEPTH OF COMPLETED WELL. . . 85 . . ft. ELEVATION: . . . . . .
Depth(s) Groundwater Encountered 1. . . 44 . . . . . ft. 2. . . . . ft. 3. . . . . ft.
WELL'S STATIC WATER LEVEL . . . 38 . . . ft. below land surface measured on mo/day/yr 8-4-02 . . . . . .
Pump test data: Well water was . . . . . ft. after . . . . . hours pumping . . . . . gpm
Est. Yield . . . . . gpm: Well water was . . . . . ft. after . . . . . hours pumping . . . . . gpm
Bore Hole Diameter. . . 10 . . . in. to . . . 85 . . . . . ft., and. . . . . in. to . . . . . ft.
WELL WATER TO BE USED AS: 5 Public water supply 8 Air conditioning 11 Injection well
1 Domestic 3 Feedlot 6 Oil field water supply 9 Dewatering 12 Other (Specify below)
2 Irrigation 4 Industrial 7 Domestic (lawn & garden) 10 Monitoring well . . . . . .
Was a chemical/bacteriological sample submitted to Department? Yes. . . . . No. ✓ . . . ; If yes, mo/day/yrs sample was submitted
Water Well Disinfected? Yes ✓ No

5 TYPE OF BLANK CASING USED: 5 Wrought iron 8 Concrete tile CASING JOINTS: Glued. ✓ . . . Clamped. . . . . .
1 Steel 3 RMP (SR) 6 Asbestos-Cement 9 Other (specify below) Welded . . . . . .
2 PVC 4 ABS 7 Fiberglass . . . . . Threaded. . . . . .
Blank casing diameter . . . 5 . . . . . in. to . . 85 . . . . . ft., Dia . . . . . in. to . . . . . ft., Dia . . . . . in. to . . . . . ft.
Casing height above land surface. . . . 14 . . . . . in., weight . . . 160 . . . . . lbs./ft. Wall thickness or gauge No. . 26 . . . . . .
TYPE OF SCREEN OR PERFORATION MATERIAL: 7 PVC 10 Asbestos-cement
1 Steel 3 Stainless steel 5 Fiberglass 8 RMP (SR) 11 Other (specify) . . . . . .
2 Brass 4 Galvanized steel 6 Concrete tile 9 ABS 12 None used (open hole)
SCREEN OR PERFORATION OPENINGS ARE: 5 Gauzed wrapped 8 Saw cut 11 None (open hole)
1 Continuous slot 3 Mill slot 6 Wire wrapped 9 Drilled holes
2 Louvered shutter 4 Key punched 7 Torch cut 10 Other (specify) . . . . . ft.
SCREEN-PERFORATED INTERVALS: From. . . 65 . . . . . ft. to . . 85 . . . . . ft., From . . . . . ft. to. . . . . ft.
From. . . . . ft. to . . . . . ft., From . . . . . ft. to. . . . . ft.
GRAVEL PACK INTERVALS: From. . . 25 . . . . . ft. to . . 85 . . . . . ft., From . . . . . ft. to. . . . . ft.
From. . . . . ft. to . . . . . ft., From . . . . . ft. to. . . . . ft.

6 GROUT MATERIAL: 1 Neat cement 2 Cement grout 3 Bentonite 4 Other . . . . . .
Grout Intervals: From. . . 3 . . . . . ft. to 2 . . . . . ft., From . . . . . ft. to. . . . . ft., From . . . . . ft. to. . . . . ft.
What is the nearest source of possible contamination: 10 Livestock pens 14 Abandoned water well
1 Septic tank 4 Lateral lines 7 Pit privy 11 Fuel storage 15 Oil well/Gas well
2 [redacted] 5 Cess pool 8 Sewage lagoon 12 Fertilizer storage 16 Other (specify below)
3 Watertight sewer lines 6 Seepage pit 9 Feedyard 13 Insecticide storage . . . . . .
Direction from well? South How many feet? 20'

FROM	TO	LITHOLOGIC LOG	FROM	TO	PLUGGING INTERVALS
0	2	TOP SOIL			
2	32	Clay			
32	44	fine Sand clay			
44	63	Sand			
63	85	Med- coarse gravel			

7 CONTRACTOR'S OR LANDOWNER'S CERTIFICATION: This water well was (1) constructed, (2) reconstructed, or (3) plugged under my jurisdiction and was completed on (mo/day/year) . . . 8-4-02 . . . . . and this record is true to the best of my knowledge and belief. Kansas Water Well Contractor's Licence No. . 6611 . . . . . This Water Well Record was completed on (mo/day/yr) . . . 8-5-02 . . . . . under the business name of Chase Drilling by (signature) [signature]

INSTRUCTIONS: Use typewriter or ball point pen. *PLEASE PRESS FIRMLY* and *PRINT* clearly. Please fill in blanks, underline or circle the correct answers. Send top three copies to Kansas Department of Health and Environment, Bureau of Water, Topeka, Kansas 66620-0001. Telephone 785-296-5524. Send one to WATER WELL OWNER and retain one for your records. Fee of $5.00 for each constructed well.