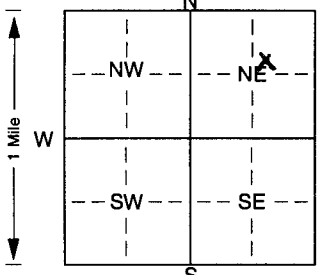


|   |           |                                                                                                 |                   |                                                   |                          |
|---|-----------|-------------------------------------------------------------------------------------------------|-------------------|---------------------------------------------------|--------------------------|
| <b>1 LOCATION OF WATER WELL:</b>   |           | Fraction                                                                                        | Section Number    | Township Number                                   | Range Number             |
| County: <u>Sedgwick</u>   |           | <u>9/16</u> <u>1/4</u> <u>NE</u> <u>1/4</u> <u>NW</u> <u>1/4</u>                                | <u>6</u>          | T <u>27</u> S <u>1</u>                            | R <u>1</u> E <u>1</u>    |
| Distance and direction from nearest town or city street address of well if located within city?<br><u>Jerry Simon's 10913 Central Park Ct Wichita KS</u>   |           |                                                                                                 |                   |                                                   |                          |
| <b>2 WATER WELL OWNER:</b> <u>Jerry Simon's</u>   |           |                                                                                                 |                   |                                                   |                          |
| RR#, St. Address, Box # : <u>10913 Central Park Ct</u>   |           |                                                                                                 |                   | Board of Agriculture, Division of Water Resources |                          |
| City, State, ZIP Code : <u>Wichita KS.</u>   |           |                                                                                                 |                   | Application Number:                               |                          |
| <b>3 LOCATE WELL'S LOCATION WITH</b>   |           | <b>4 DEPTH OF COMPLETED WELL:</b> <u>58</u> ft. ELEVATION: .....                                |                   |                                                   |                          |
| AN "X" IN SECTION BOX:   |           | Depth(s) Groundwater Encountered 1. <u>26</u> ft. 2. .... ft. 3. .... ft.                       |                   |                                                   |                          |
|   |           | WELL'S STATIC WATER LEVEL <u>26</u> ft. below land surface measured on mo/day/yr <u>10-8-02</u> |                   |                                                   |                          |
|   |           | Pump test data: Well water was ..... ft. after ..... hours pumping ..... gpm                    |                   |                                                   |                          |
|   |           | Est. Yield ..... gpm: Well water was ..... ft. after ..... hours pumping ..... gpm              |                   |                                                   |                          |
|   |           | Bore Hole Diameter. <u>10</u> in. to <u>58</u> ft., and ..... in. to ..... ft.                  |                   |                                                   |                          |
| WELL WATER TO BE USED AS:   |           | 5 Public water supply 8 Air conditioning 11 Injection well                                      |                   |                                                   |                          |
| 1 Domestic 3 Feedlot 6 Oil field water supply 9 Dewatering 12 Other (Specify below)   |           |                                                                                                 |                   |                                                   |                          |
| 2 Irrigation 4 Industrial 7 Domestic (lawn & garden) 10 Monitoring well   |           |                                                                                                 |                   |                                                   |                          |
| Was a chemical/bacteriological sample submitted to Department? Yes. .... No. <u>✓</u> ; If yes, mo/day/yr sample was submitted   |           |                                                                                                 |                   |                                                   |                          |
| Water Well Disinfected? Yes <u>✓</u> No   |           |                                                                                                 |                   |                                                   |                          |
| <b>5 TYPE OF BLANK CASING USED:</b>   |           |                                                                                                 |                   |                                                   |                          |
| 1 Steel   |           | 3 RMP (SR)                                                                                      | 6 Asbestos-Cement | 9 Other (specify below)                           | Welded .....             |
| <u>2 PVC</u>   |           | 4 ABS                                                                                           | 7 Fiberglass      |                                                   | Threaded .....           |
| Blank casing diameter ... <u>5</u> in. to <u>58</u> ft., Dia ..... in. to ..... ft., Dia ..... in. to ..... ft.   |           |                                                                                                 |                   |                                                   |                          |
| Casing height above land surface. <u>14</u> in., weight <u>160</u> lbs./ft. Wall thickness or gauge No. <u>26</u>   |           |                                                                                                 |                   |                                                   |                          |
| <b>TYPE OF SCREEN OR PERFORATION MATERIAL:</b>   |           |                                                                                                 |                   |                                                   |                          |
| 1 Steel   |           | 3 Stainless steel                                                                               | 5 Fiberglass      | 8 RMP (SR)                                        | 10 Asbestos-cement       |
| 2 Brass   |           | 4 Galvanized steel                                                                              | 6 Concrete tile   | 9 ABS                                             | 11 Other (specify) ..... |
|   |           |                                                                                                 |                   |                                                   | 12 None used (open hole) |
| <b>SCREEN OR PERFORATION OPENINGS ARE:</b>   |           |                                                                                                 |                   |                                                   |                          |
| 1 Continuous slot   |           | 3 Mill slot                                                                                     | 5 Gauzed wrapped  | 8 Saw cut                                         | 11 None (open hole)      |
| 2 Louvered shutter   |           | 4 Key punched                                                                                   | 6 Wire wrapped    | 9 Drilled holes                                   |                          |
|   |           |                                                                                                 | 7 Torch cut       | 10 Other (specify) .....                          | ft.                      |
| <b>SCREEN-PERFORATED INTERVALS:</b> From <u>48</u> ft. to <u>58</u> ft., From ..... ft. to ..... ft.   |           |                                                                                                 |                   |                                                   |                          |
| GRAVEL PACK INTERVALS: From <u>20</u> ft. to <u>58</u> ft., From ..... ft. to ..... ft.   |           |                                                                                                 |                   |                                                   |                          |
| <b>6 GROUT MATERIAL:</b> 1 Neat cement 2 Cement grout <u>3 Bentonite</u> 4 Other .....   |           |                                                                                                 |                   |                                                   |                          |
| Grout Intervals: From <u>2</u> ft. to <u>20</u> ft., From ..... ft. to ..... ft., From ..... ft. to ..... ft.   |           |                                                                                                 |                   |                                                   |                          |
| What is the nearest source of possible contamination:   |           |                                                                                                 |                   |                                                   |                          |
| 1 Septic tank   |           | 4 Lateral lines                                                                                 | 7 Pit privy       | 10 Livestock pens                                 | 14 Abandoned water well  |
| 2 Sewer lines   |           | 5 Cess pool                                                                                     | 8 Sewage lagoon   | 11 Fuel storage                                   | 15 Oil well/Gas well     |
| <u>3 Water/light sewer lines</u>   |           | 6 Seepage pit                                                                                   | 9 Feedyard        | 12 Fertilizer storage                             | 16 Other (specify below) |
|   |           |                                                                                                 |                   | 13 Insecticide storage                            |                          |
| Direction from well? <u>West</u> How many feet? <u>20</u>   |           |                                                                                                 |                   |                                                   |                          |
| FROM   | TO        | LITHOLOGIC LOG                                                                                  | FROM              | TO                                                | PLUGGING INTERVALS       |
| <u>0</u>   | <u>2</u>  | <u>Top Soil</u>                                                                                 |                   |                                                   |                          |
| <u>2</u>   | <u>17</u> | <u>clay</u>                                                                                     |                   |                                                   |                          |
| <u>17</u>   | <u>26</u> | <u>med sand</u>                                                                                 |                   |                                                   |                          |
| <u>26</u>   | <u>58</u> | <u>coarse sand</u>                                                                              |                   |                                                   |                          |
|   | <u>58</u> | <u>clay</u>                                                                                     |                   |                                                   |                          |
| <b>7 CONTRACTOR'S OR LANDOWNER'S CERTIFICATION:</b> This water well was (1) <u>constructed</u> (2) reconstructed, or (3) plugged under my jurisdiction and was completed on (mo/day/year) <u>10-8-02</u> and this record is true to the best of my knowledge and belief. Kansas Water Well Contractor's Licence No. <u>Cell</u> This Water Well Record was completed on (mo/day/yr) <u>10-8-02</u> under the business name of <u>Chase Drilling</u> by (signature) <u>[Signature]</u> |           |                                                                                                 |                   |                                                   |                          |
| INSTRUCTIONS: Use typewriter or ball point pen. PLEASE PRESS FIRMLY and PRINT clearly. Please fill in blanks, underline or circle the correct answers. Send top three copies to Kansas Department of Health and Environment, Bureau of Water, Topeka, Kansas 66620-0001. Telephone 785-296-5524. Send one to WATER WELL OWNER and retain one for your records. Fee of \$5.00 for each constructed well.                                                                               |           |                                                                                                 |                   |                                                   |                          |