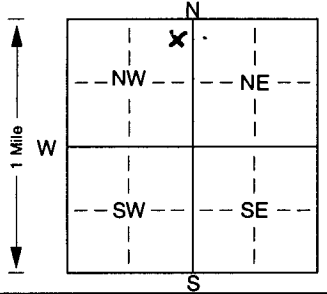


T. 27 s.

1 LOCATION OF WATER WELL:		FRACTION		SECTION NUMBER		TOWNSHIP NUMBER		RANGE NUMBER	
County: Sedgewick		1/4 9400 1/4 84E		6		T 74N S		R 1 E	
Distance and direction from nearest town or city street address of well if located within city? Shannon Fisher 2746 Park Ridge ^{et} Wichita KS									
2 WATER WELL OWNER: Shannon Fisher									
RR#, St. Address, Box # : 2746 Park Ridge ^{et}					Board of Agriculture, Division of Water Resources				
City, State, ZIP Code : Wichita KS					Application Number:				
3 LOCATE WELL'S LOCATION WITH AN "X" IN SECTION BOX:			4 DEPTH OF COMPLETED WELL: 7.5 ft. ELEVATION:						
			Depth(s) Groundwater Encountered 1. 34' ft. 2. ft. 3. ft.						
			WELL'S STATIC WATER LEVEL 34' ft. below land surface measured on mo/day/yr 9-23-02						
			Pump test data: Well water was ft. after hours pumping gpm						
			Est. Yield gpm: Well water was ft. after hours pumping gpm						
			Bore Hole Diameter 10 in. to 7.5 ft. and in. to ft.						
			WELL WATER TO BE USED AS: 5 Public water supply 8 Air conditioning 11 Injection well						
			1 Domestic 3 Feedlot 6 Oil field water supply 9 Dewatering 12 Other (Specify below)						
			2 Irrigation 4 Industrial 7 Domestic (lawn & garden) 10 Monitoring well						
			Was a chemical/bacteriological sample submitted to Department? Yes. No. ☒ If yes, mo/day/yr sample was submitted						
			Water Well Disinfected? Yes ☒ No						
5 TYPE OF BLANK CASING USED:									
1 Steel 3 RMP (SR) 5 Wrought iron 8 Concrete tile CASING JOINTS: Glued. ☒ Clamped. ☐									
2 PVC 4 ABS 6 Asbestos-Cement 9 Other (specify below) Welded ☐									
7 Fiberglass Threaded ☐									
Blank casing diameter 5 in. to 7.5 ft. Dia in. to ft. Dia in. to ft.									
Casing height above land surface 14 in., weight 160 lbs./ft. Wall thickness or gauge No. 26									
TYPE OF SCREEN OR PERFORATION MATERIAL:									
1 Steel 3 Stainless steel 5 Fiberglass 7 PVC 10 Asbestos-cement									
2 Brass 4 Galvanized steel 6 Concrete tile 8 RMP (SR) 11 Other (specify)									
9 ABS 12 None used (open hole)									
SCREEN OR PERFORATION OPENINGS ARE:									
1 Continuous slot 3 Mill slot 5 Gauzed wrapped 8 Saw cut 11 None (open hole)									
2 Louvered shutter 4 Key punched 6 Wire wrapped 9 Drilled holes									
7 Torch cut 10 Other (specify) ft.									
SCREEN-PERFORATED INTERVALS: From 55 ft. to 7.5 ft. From ft. to ft.									
From ft. to ft. From ft. to ft.									
GRAVEL PACK INTERVALS: From 20 ft. to 7.5 ft. From ft. to ft.									
From ft. to ft. From ft. to ft.									
6 GROUT MATERIAL: 1 Neat cement 2 Cement grout 3 Bentonite 4 Other									
Grout Intervals: From 2 ft. to 20 ft. From ft. to ft. From ft. to ft.									
What is the nearest source of possible contamination:									
1 Septic tank 4 Lateral lines 7 Pit privy 10 Livestock pens 14 Abandoned water well									
2 Sewer lines 5 Cess pool 8 Sewage lagoon 11 Fuel storage 15 Oil well/Gas well									
3 Watertight sewer lines 6 Seepage pit 9 Feedyard 12 Fertilizer storage 16 Other (specify below)									
13 Insecticide storage									
Direction from well? West How many feet? 30-35									
FROM TO LITHOLOGIC LOG FROM TO PLUGGING INTERVALS									
0 5 TOP SOIL									
5 34 clay									
34 46 med sand									
46 51 clay									
51 75 med sand									
7 CONTRACTOR'S OR LANDOWNER'S CERTIFICATION: This water well was (1) constructed (2) reconstructed, or (3) plugged under my jurisdiction and was completed on (mo/day/year) 9-23-02 and this record is true to the best of my knowledge and belief. Kansas									
Water Well Contractor's Licence No. 611 This Water Well Record was completed on (mo/day/yr) 9-23-02									
under the business name of Chase Drilling by (signature) Rick Chase									
INSTRUCTIONS: Use typewriter or ball point pen. PLEASE PRESS FIRMLY and PRINT clearly. Please fill in blanks, underline or circle the correct answers. Send top three copies to Kansas Department of Health and Environment, Bureau of Water, Topeka, Kansas 66620-0001. Telephone 785-296-5524. Send one to WATER WELL OWNER and retain one for your records. Fee of \$5.00 for each constructed well.									