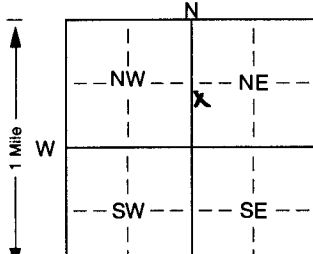


T. 27 s.

1 LOCATION OF WATER WELL:		Fraction		Section Number		Township Number		Range Number			
County: Sedgwick		NE 1/4		6		T 24		S 1 R 1 E 1			
Distance and direction from nearest town or city street address of well if located within city?											
Will Edward 2715 N Shefford St Wichita KS											
2 WATER WELL OWNER: Will Edward et											
RR#, St. Address, Box # : 2715 N Shefford St					Board of Agriculture, Division of Water Resources						
City, State, ZIP Code : Wichita KS					Application Number:						
3 LOCATE WELL'S LOCATION WITH 4 DEPTH OF COMPLETED WELL: 60 ft. ELEVATION:											
AN "X" IN SECTION BOX:			Depth(s) Groundwater Encountered 1. ft. 2. ft. 3. ft.								
			WELL'S STATIC WATER LEVEL 34 ft. below land surface measured on mo/day/yr 9-24-02								
			Pump test data: Well water was ft. after hours pumping gpm								
			Est. Yield gpm: Well water was ft. after hours pumping gpm								
			Bore Hole Diameter 10 in. to 60 ft. and in. to ft.								
			WELL WATER TO BE USED AS: 5 Public water supply 8 Air conditioning 11 Injection well								
			1 Domestic 3 Feedlot 6 Oil field water supply 9 Dewatering 12 Other (Specify below)								
			2 Irrigation 4 Industrial 7 Domestic (lawn & garden) 10 Monitoring well								
Was a chemical/bacteriological sample submitted to Department? Yes. No. If yes, mo/day/yr sample was submitted											
Water Well Disinfected? Yes No											
5 TYPE OF BLANK CASING USED:											
1 Steel			3 RMP (SR)			5 Wrought iron			8 Concrete tile		
2 PVC			4 ABS			6 Asbestos-Cement			9 Other (specify below)		
7 Fiberglass						CASING JOINTS: Glued. Clamped.					
Blank casing diameter in. to ft. Dia in. to ft. Dia in. to ft.											
Casing height above land surface 14 in., weight 160 lbs./ft. Wall thickness or gauge No. 26											
TYPE OF SCREEN OR PERFORATION MATERIAL:											
1 Steel			3 Stainless steel			5 Fiberglass			7 PVC		
2 Brass			4 Galvanized steel			6 Concrete tile			8 RMP (SR)		
									9 ABS		
									10 Asbestos-cement		
									11 Other (specify)		
									12 None used (open hole)		
SCREEN OR PERFORATION OPENINGS ARE:											
1 Continuous slot			3 Mill slot			5 Gauzed wrapped			8 Saw cut		
2 Louvered shutter			4 Key punched			6 Wire wrapped			9 Drilled holes		
						7 Torch cut			10 Other (specify)		
11 None (open hole)											
SCREEN-PERFORATED INTERVALS: From 50 ft. to 60 ft. From ft. to ft. From ft. to ft. From ft. to ft.											
GRAVEL PACK INTERVALS: From 20 ft. to 60 ft. From ft. to ft. From ft. to ft. From ft. to ft.											
6 GROUT MATERIAL:											
1 Neat cement			2 Cement grout			3 Bentonite			4 Other		
Grout Intervals: From 2 ft. to 20 ft. From ft. to ft. From ft. to ft. From ft. to ft.											
What is the nearest source of possible contamination:											
1 Septic tank			4 Lateral lines			7 Pit privy			10 Livestock pens		
2 Sewer lines			5 Cess pool			8 Sewage lagoon			11 Fuel storage		
3 Water tight sewer lines			6 Seepage pit			9 Feedyard			12 Fertilizer storage		
									13 Insecticide storage		
									14 Abandoned water well		
									15 Oil well/Gas well		
									16 Other (specify below)		
Direction from well? West											
How many feet? 30'											
FROM TO LITHOLOGIC LOG FROM TO PLUGGING INTERVALS											
0 2 Top Soil											
2 31 clay											
31 34 fine sand											
34 57 med coarse-sand											
57 60 clay											
7 CONTRACTOR'S OR LANDOWNER'S CERTIFICATION: This water well was (1) constructed, (2) reconstructed, or (3) plugged under my jurisdiction and was completed on (mo/day/year) 9-24-02 and this record is true to the best of my knowledge and belief. Kansas Water Well Contractor's Licence No. 611 This Water Well Record was completed on (mo/day/yr) 9-24-02 under the business name of Chase Drilling by (signature) Phil Chase											
INSTRUCTIONS: Use typewriter or ball point pen. PLEASE PRESS FIRMLY and PRINT clearly. Please fill in blanks, underline or circle the correct answers. Send top three copies to Kansas Department of Health and Environment, Bureau of Water, Topeka, Kansas 66620-0001. Telephone 785-296-5524. Send one to WATER WELL OWNER and retain one for your records. Fee of \$5.00 for each constructed well.											