


1 LOCATION OF WATER WELL:	Fraction <u>SW NW SE NE</u> <u>SE NE</u>	Section Number <u>29</u>	Township Number <u>27</u>	Range Number <u>12W</u>
County: <u>Sedgewick</u>				

Distance and direction from nearest town or city street address of well if located within city?
MYRON Klausser 500 Maybelle

2 WATER WELL OWNER: <u>MYRON Klausser</u> <u>500 Maybelle</u>	Board of Agriculture, Division of Water Resources Application Number: _____
RR #, St. Address, Box #: _____ City, State, ZIP Code: <u>Wichita, KS</u>	

3 MARK WELL'S LOCATION WITH AN "X" IN SECTION BOX:	4 DEPTH OF WELL <u>45</u> ft. WELL'S STATIC WATER LEVEL <u>22</u> ft. WELL WAS USED AS: <u>1 Domestic</u> 2 Irrigation 3 Feedlot 4 Industrial 5 Public Water Supply 6 Oil Field Water Supply 7 Domestic (Lawn & Garden) 8 Air Conditioning 9 Dewatering 10 Monitoring Well 11 Injection Well 12 Other _____
--	---

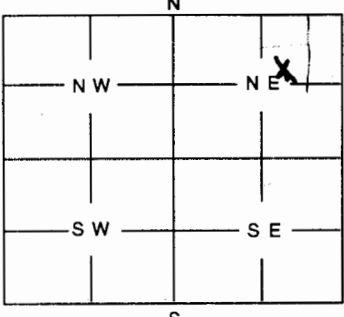

N
NW NE
W E
SW SE
S

Was a chemical / bacteriological sample submitted to Department? Yes _____ No ☒

If yes, mo/day/yr sample was submitted _____

Water Well Disinfected: Yes ☒ No _____

5 TYPE OF BLANK CASING USED:

1 Steel	3 RMP (SR)	5 Wrought	7 Fiberglass	9 Other (Specify below)
2 PVC	4 ABS	6 Asbestos-Cement	8 Concrete Tile	<u>Stove pipe</u>

Blank casing diameter 4 in. Was casing pulled? Yes ☒ No _____ If yes, how much TOP 5'
Casing height above or below land surface 5 in.

6 GROUT PLUG MATERIAL: 1 Neat cement 2 Cement grout 3 Bentonite 4 Other _____

Grout Plug Intervals: From 0 ft. to 45 ft., From _____ ft. to _____ ft., From _____ ft. to _____ ft.

What is the nearest source of possible contamination:

1 Septic tank	6 Seepage pit	11 Fuel storage	16 Other (specify below)
2 Sewer lines	7 Pit privy	12 Fertilizer storage	
<u>2 Watertight sewer lines</u>	8 Sewage lagoon	13 Insecticide storage	
4 Lateral lines	9 Feedyard	14 Abandoned water well	
5 Cess Pool	10 Livestock pens	15 Oil well/Gas well	

Direction from well? North How many feet? 40'

FROM	TO	PLUGGING MATERIALS
<u>0</u>	<u>45</u>	<u>neat cement</u>

Well had 6" surface pipe
We were not able to remove casing
4" stove pipe top 5' pulled from
Well, Well was in Well pit

7 CONTRACTOR'S OR LANDOWNER'S CERTIFICATION: This water well was plugged under my jurisdiction and was completed on (mo/day/year) 10-14-02 and this record is true to the best of my knowledge and belief. Kansas Water Well Contractor's License No. 611 This Water Well Record was completed on (mo/day/year) 10-14-02 under the business name of Chase Drilling
by (signature) [Signature]

INSTRUCTIONS: Use typewriter or ball point pen. Please press firmly and print clearly. Please fill in blanks, underline or circle the correct answers. Send top three copies to Kansas Department of Health and Environment, Bureau of Water, Topeka, Kansas 66620-0001. Telephone: 785/296-3565. Send one to Water Well Owner and retain one for your records.