**CORRECTION(S) TO WATER WELL RECORD (WWC-5)**

(to rectify lacking or incorrect information)

County: Sedgwick

| **Location listed as:** | **Location changed to:** |
|---|---|
| Section-Township-Range: None Given | 24-27S-1W |
| Fraction ( ¼ ¼ ¼): | SE SW SW |

**Other changes:** Initial statements:

Changed to:

Comments:

verification method: Well address, city map, and Wichita West 1:24,000 topo. map.

initials: DRL date: 6/26/2003

submitted by: Kansas Geological Survey, Data Resources Library, 1930 Constant Ave., Lawrence, KS 66047-3726
to: Kansas Dept of Health & Environment, Bureau of Water, 1000 SW Jackson, Suite 420, Topeka, KS 66612-1367.

WATER WELL PLUGGING RECORD Form WWC-5P KSA 82a-1212 ID NO. _____

| 1 LOCATION OF WATER WELL: | Fraction | Section Number | Township Number | Range Number |
|---|---|---|---|---|
| County: Sedwick | ¼ ¼ ¼ | | | E/W |

Distance and direction from nearest town or city street address of well if located within city?
213 S. Kessler Wichita, Ks 67213

2 WATER WELL OWNER: Dan Schneweis Schneweis
RR #, St. Address, Box #: 213 S. Kessler
City, State, ZIP Code : Wichita, Ks 67213
Board of Agriculture, Division of Water Resources
Application Number:

3 MARK WELL'S LOCATION WITH AN "X" IN SECTION BOX:

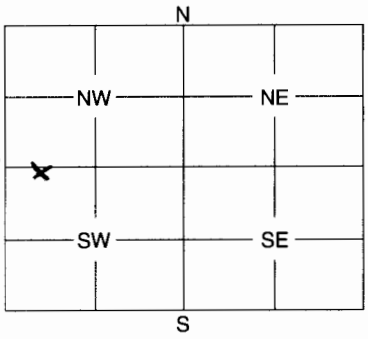


4 DEPTH OF WELL 19 ft.
WELL'S STATIC WATER LEVEL 9 ft.
WELL WAS USED AS:

| | | |
|---|---|---|
| 1 Domestic | 5 Public Water Supply | 9 Dewatering |
| 2 Irrigation | 6 Oil Field Water Supply | 10 Monitoring Well |
| 3 Feedlot | (7) Domestic (Lawn & Garden) | 11 Injection Well |
| 4 Industrial | 8 Air Conditioning | (12) Other lawn/garden |

Was a chemical / bacteriological sample submitted to Department? Yes ..... No ✓
If yes, mo/day/yr sample was submitted .....
Water Well Disinfected: Yes ✓ No .....

5 TYPE OF BLANK CASING USED:

| | | | | |
|---|---|---|---|---|
| (1) Steel | 3 RMP (SR) | 5 Wrought | 7 Fiberglass | 9 Other (Specify below) |
| 2 PVC | 4 ABS | 6 Asbestos-Cement | 8 Concrete Tile | |

Blank casing diameter 2 in. Was casing pulled? Yes ✓ No ..... If yes, how much 19 ft (sucked up by sand point)
Casing height above or below land surface ..... in.

6 GROUT PLUG MATERIAL: (1) Neat cement 2 Cement grout 3 Bentonite 4 Other .....
Grout Plug Intervals: From 19 ft. to 0 ft., From ..... ft. to ..... ft., From ..... to ..... ft.

What is the nearest source of possible contamination:

| | | | |
|---|---|---|---|
| 1 Septic tank | 6 Seepage pit | 11 Fuel storage | 16 Other (specify below) |
| 2 Sewer lines | 7 Pit privy | 12 Fertilizer storage | ..... |
| (3) Watertight sewer lines | 8 Sewage lagoon | 13 Insecticide storage | |
| 4 Lateral lines | 9 Feedyard | 14 Abandoned water well | |
| 5 Cess pool | 10 Livestock pens | 15 Oil well/Gas well | |

Direction from well? Northwest How many feet? 10 ft

| FROM | TO | PLUGGING MATERIALS |
|---|---|---|
| bottom | top | Neat cement |
| | | |
| | | |
| | | |
| | | |
| | | |
| | | |

7 CONTRACTOR'S OR LANDOWNER'S CERTIFICATION: This water well was plugged under my jurisdiction and was completed on (mo/day/year) 9/26/02 and this record is true to the best of my knowledge and belief. Kansas Water Well Contractor's License No. ..... This Water Well Record was completed on (mo/day/year) ..... under the business name of .....
by (signature) .....

INSTRUCTIONS: Use typewriter or ball point pen. Please press firmly and print clearly. Please fill in blanks, underline or circle the correct answers. Send top three copies to Kansas Department of Health and Environment, Bureau of Water, Geology Section, 1000 SW Jackson St., Ste. 420, Topeka, Kansas 66612-1367. Telephone: 785/296-5522. Send one to Water Well Owner and retain one for your records.