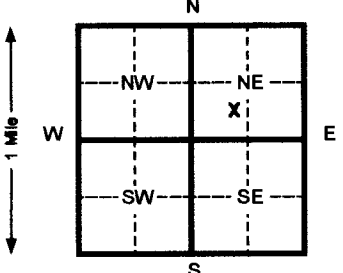


1 LOCATION OF WATER WELL:		Fraction	Section Number		Township Number	Range Number	
County: SEDGWICK		NW % SE % SW %	6		T 27S S	R 1W EW	
Distance and direction from nearest town or city street address of well if located within city?							
2641 N PARKDALE, WICHITA							
2 WATER WELL OWNER: CESAR LUNA							
RR#, St. Address, Box # : 2641 N PARKDALE				Board of Agriculture, Division of Water Resources			
City, State, ZIP Code : WICHITA, KS				Application Number:			
3 LOCATE WELL'S LOCATION WITH AN "X" IN SECTION BOX:		4 DEPTH OF COMPLETED WELL 60 ft. ELEVATION:					
		Depth(s) Groundwater Encountered 1 28 ft. 2 ft. 3 ft.					
		WELL'S STATIC WATER LEVEL 28 ft. below land surface measured on mo/day/yr 1/17/03					
		Pump test data: Well water was ft. after hours pumping gpm					
		Est. Yield gpm: Well water was ft. after hours pumping gpm					
		Bore Hole Diameter 10 in. to 60 ft. and in. to ft.					
		WELL WATER TO BE USED AS: 5 Public water supply 8 Air conditioning 11 Injection well					
		1 Domestic 3 Feed lot 6 Oil field water supply 9 Dewatering 12 Other (Specify below)					
		Lawn and garden					
		2 Irrigation 4 Industrial 7 (domestic) 10 Monitoring well					
		Was a chemical/bacteriological sample submitted to Department? Yes No X If yes, mo/day/yr sample was submitted					
		Water Well Disinfected? Yes X No					
5 TYPE OF BLANK CASING USED:							
1 Steel 3 RMP (SR) 5 Wrought Iron 8 Concrete tile CASING JOINTS: Glued X Clamped							
2 PVC 4 ABS 6 Asbestos-Cement 9 Other (specify below) Welded							
7 Fiberglass Threaded							
Blank casing diameter 5 in. to 60 ft., Dia in. to ft., Dia in. to ft.							
Casing height above land surface 14 in., weight 160 lbs./ft. Wall thickness or gauge No. 26							
TYPE OF SCREEN OR PERFORATION MATERIAL:							
1 Steel 3 Stainless steel 5 Fiberglass 7 PVC 10 Asbestos-cement							
2 Brass 4 Galvanized steel 6 Concrete tile 8 RMP (SR) 11 Other (specify)							
9 ABS 12 None used (open hole)							
SCREEN OR PERFORATION OPENINGS ARE:							
1 Continuous slot 3 Mill slot 5 Gauzed wrapped 8 Saw cut 11 None (open hole)							
2 Louvered shutter 4 Key punched 6 Wire wrapped 9 Drilled holes							
7 Torch cut 10 Other (specify)							
SCREEN-PERFORATED INTERVALS: From 50 ft. to 60 ft. From ft. to ft.							
From ft. to ft. From ft. to ft.							
GRAVEL PACK INTERVALS: From 24 ft. to 60 ft. From ft. to ft.							
From ft. to ft. From ft. to ft.							
6 GROUT MATERIAL: 1 Neat cement 2 Cement grout 3 Bentonite 4 Other							
Grout Intervals From ft. to ft. From ft. to ft. From ft. to ft.							
What is the nearest source of possible contamination:							
1 Septic tank 4 Lateral lines 7 Pit privy 10 Livestock pens 14 Abandoned water well							
2 Sewer lines 5 Cess pool 8 Sewage lagoon 11 Fuel storage 15 Oil well/ Gas well							
3 Watertight sewer lines 6 Seepage pit 9 Feedyard 12 Fertilizer storage 16 Other (specify below)							
13 Insecticide storage							
Direction from well? EAST How many feet? 20							
FROM TO CODE LITHOLOGIC LOG FROM TO PLUGGING INTERVALS							
0 2 TOPSOIL							
2 27 CLAY							
27 31 FINE SAND							
31 60 MED SAND							
CONTRACTOR'S OR LANDOWNER'S CERTIFICATION: This water well was (1) constructed, (2) reconstructed, or (3) plugged under my jurisdiction and was							
completed on (mo/day/yr) 1/17/03 and this record is true to the best of my knowledge and belief. Kansas							
Water Well Contractor's License No. 611 This Water Well Record was completed on (mo/day/yr) 1/17/03							
under the business name of CHASE DRILLING by (signature) RICK CHASE							

OFFICE USE ONLY

—

20

SEC