CORRECTION(S) TO WATER WELL RECORD (WWC-5)

(to rectify lacking or incorrect information)

County: Sedgwick

Location listed as:	Location changed to:
Section-Township-Range: 27 - 27S - 1W	27 - 27S - 1W
Fraction (¼ ¼ ¼): NW NW ¼ SE	NW NW SE

Other changes: Initial statements: Location changed:

Listed: 13333 W Kellogg

Changed to: 6333 W Kellogg

Comments:

verification method: Wichita map, online mapping service, phone call to driller

initials: JB date: 10-12-2004

submitted by: Kansas Geological Survey, Data Resources Library, 1930 Constant Ave., Lawrence, KS 66047-3726

GSI Job No. 2111021 **SPG-1**

WATER WELL PLUGGING RECORD Form WWC-5P KSA 82a-1212 ID No. _____

1 LOCATION OF WATER WELL:	Fraction	Section Number	Township Number	Range Number
County: **Sedgwick**	**NW ¼ NW ¼ SE ¼**	**27**	**27**	**01 W**

Distance and direction from nearest town or city street address of well if located within city?
1333 W. Kellogg, Wichita; 23' W, 73'S of SW corner of Chuck Dahlem

2 WATER WELL OWNER: **Chuck Dahlem**
RR#, St. Address, Box # **11409 Lost Creek Circle**
City, State, ZIP Code : **Wichita, KS 67212**
Board of Agriculture, Division of Water Resources
Application Number:

3 MARK WELL'S LOCATON WITH AN "X" IN SECTION BOX:

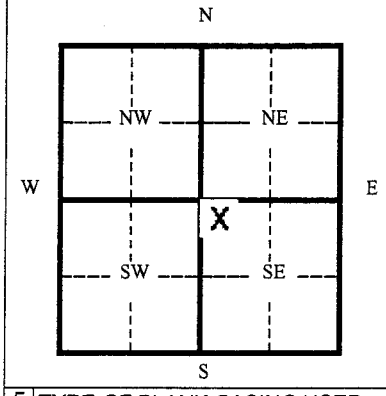

4 DEPTH OF WELL **20** ft.

WELL'S STATIC WATER LEVEL **12.74** ft.

WELL WAS USED AS:

1 Domestic 5 Public Water Supply 9 Dewatering
2 Irrigation 6 Oil Field Water Supply 10 Monitoring Well
3 Feedlot 7 Lawn and Garden (domestic) 11 Injection Well
4 Industrial 8 Air Conditioning (12 Other)

Was a chemical/bacteriological sample submitted to Department? Yes ____ No X
If yes, mo/day/yr sample was submitted _____
Water Well Disinfected: Yes ____ No X

5 TYPE OF BLANK CASING USED:

1 Steel 3 RMP (SR) 5 Wrought 7 Fiberglass 9 Other (specify below)
(2 PVC) 4 ABC 6 Asbestos-Cement 8 Concrete Tile

Blank casing diameter **2** in. Was casing pulled? Yes **X** No ____ If yes, how much **20**

Casing height above or below land surface **0** in. **Overdrilled to 20' bgs**

6 GROUT PLUG MATERIAL: 1 Neat cement 2 Cement grout (3 Bentonite) 4 Other _____

Grout Plug Intervals From **0** ft. to **20** ft. From _____ ft. to _____ ft. From _____ ft. to _____ ft.

What is the nearest source of possible contamination:

1 Septic tank 6 Seepage pit 11 Fuel storage 16 Other (specify below)
2 Sewer lines 7 Pit privy 12 Fertilizer storage
3 Watertight sewer lines 8 Sewage lagoon 13 Insecticide storage
4 Lateral lines 9 Feedyard 14 Abandoned water well
5 Cess Pool 10 Livestock pens 15 Oil well/ Gas well

Direction from well? _____ How many feet? _____

FROM	TO	CODE	PLUGGING MATERIALS
0	20		**Bentonite**

7 CONTRACTOR'S OR LANDOWNER'S CERTIFICATION: This water well was plugged under my jurisdiction and was completed on (mo/day/yr) **5-20-2003** and this record is true to the best of my knowledge and belief. Kansas Water Well Contractor's License No. **531** This Water Well Record was completed on (mo/day/yr) **6-20-2003** under the business name of **Geotechnical Services, Inc.**

by (signature) _____

INSTRUCTIONS: Please fill in blanks and circle the correct answers. Send three copies to Kansas Department of Health and Environment, Bureau of Water, 1000 S W Jackson St., Ste. 420, Topeka, Kansas 66620-0001. Telephone: 785-296-3565. Send one to Water Well Owner and retain one for your records.