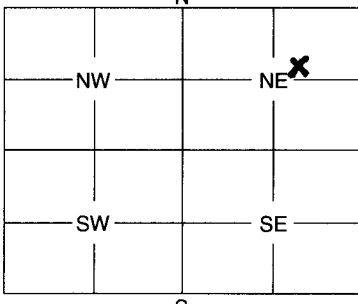
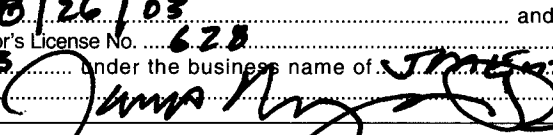


1	LOCATION OF WATER WELL:	Fraction	Section	Number	Township	Number	Range	Number																								
	County: SEDGWICK	SW 1/4 NE 1/4 NE 1/4	17	T27S	R1W	E/W																										
Distance and direction from nearest town or city street address of well if located within city? basement - 8923 W. 11th St. Wichita KS 67212																																
2	WATER WELL OWNER:		Board of Agriculture, Division of Water Resources																													
	RR #, St. Address, Box #:		Application Number:																													
	City, State, ZIP Code		Wichita KS 67212																													
3	MARK WELL'S LOCATION WITH AN "X" IN SECTION BOX:		DEPTH OF WELL 40 ft.																													
			WELL'S STATIC WATER LEVEL 32 ft.																													
			WELL WAS USED AS:																													
			<table border="0"><tr><td>1 Domestic</td><td>5 Public Water Supply</td><td>9 Dewatering</td></tr><tr><td>2 Irrigation</td><td>6 Oil Field Water Supply</td><td>10 Monitoring Well</td></tr><tr><td>3 Feedlot</td><td>7 <u>Domestic (Lawn & Garden)</u></td><td>11 Injection Well</td></tr><tr><td>4 Industrial</td><td>8 Air Conditioning</td><td>12 Other</td></tr></table>						1 Domestic	5 Public Water Supply	9 Dewatering	2 Irrigation	6 Oil Field Water Supply	10 Monitoring Well	3 Feedlot	7 <u>Domestic (Lawn & Garden)</u>	11 Injection Well	4 Industrial	8 Air Conditioning	12 Other												
1 Domestic	5 Public Water Supply	9 Dewatering																														
2 Irrigation	6 Oil Field Water Supply	10 Monitoring Well																														
3 Feedlot	7 <u>Domestic (Lawn & Garden)</u>	11 Injection Well																														
4 Industrial	8 Air Conditioning	12 Other																														
			Was a chemical / bacteriological sample submitted to Department? Yes No X																													
			If yes, mo/day/yr sample was submitted																													
			Water Well Disinfected: Yes X No																													
5	TYPE OF BLANK CASING USED:																															
	<table border="0"><tr><td>1 Steel</td><td>3 RMP (SR)</td><td>5 Wrought</td><td>7 Fiberglass</td><td>9 Other (Specify below)</td></tr><tr><td>2 PVC</td><td>4 ABS</td><td>6 Asbestos-Cement</td><td>8 Concrete Tile</td><td></td></tr></table>								1 Steel	3 RMP (SR)	5 Wrought	7 Fiberglass	9 Other (Specify below)	2 PVC	4 ABS	6 Asbestos-Cement	8 Concrete Tile															
1 Steel	3 RMP (SR)	5 Wrought	7 Fiberglass	9 Other (Specify below)																												
2 PVC	4 ABS	6 Asbestos-Cement	8 Concrete Tile																													
	Blank casing diameter 4 in. Was casing pulled? Yes No X If yes, how much																															
	Casing height above or below land surface -0- in.																															
6	GROUT PLUG MATERIAL: 1 Neat cement 2 Cement grout 3 Bentonite 4 Other																															
	Grout Plug Intervals: From 15 ft. to 3 ft., From 3 ft. to 0 ft., From to ft.																															
	What is the nearest source of possible contamination:																															
	<table border="0"><tr><td>1 Septic tank</td><td>6 Seepage pit</td><td>11 Fuel storage</td><td>15 Other (specify below)</td></tr><tr><td>2 Sewer lines</td><td>7 Pit privy</td><td>12 Fertilizer storage</td><td>Well was abandoned</td></tr><tr><td>3 Watertight sewer lines</td><td>8 Sewage lagoon</td><td>13 Insecticide storage</td><td></td></tr><tr><td>4 Lateral lines</td><td>9 Feedyard</td><td>14 Abandoned water well</td><td></td></tr><tr><td>5 Cess pool</td><td>10 Livestock pens</td><td>15 Oil well/Gas well</td><td></td></tr></table>								1 Septic tank	6 Seepage pit	11 Fuel storage	15 Other (specify below)	2 Sewer lines	7 Pit privy	12 Fertilizer storage	Well was abandoned	3 Watertight sewer lines	8 Sewage lagoon	13 Insecticide storage		4 Lateral lines	9 Feedyard	14 Abandoned water well		5 Cess pool	10 Livestock pens	15 Oil well/Gas well					
1 Septic tank	6 Seepage pit	11 Fuel storage	15 Other (specify below)																													
2 Sewer lines	7 Pit privy	12 Fertilizer storage	Well was abandoned																													
3 Watertight sewer lines	8 Sewage lagoon	13 Insecticide storage																														
4 Lateral lines	9 Feedyard	14 Abandoned water well																														
5 Cess pool	10 Livestock pens	15 Oil well/Gas well																														
	Direction from well? How many feet?																															
<table border="1"><thead><tr><th>FROM</th><th>TO</th><th>PLUGGING MATERIALS</th></tr></thead><tbody><tr><td>3</td><td>0</td><td>Cement</td></tr><tr><td>15</td><td>3</td><td>Bentonite</td></tr><tr><td>40</td><td>15</td><td>Gravel / bleach</td></tr><tr><td> </td><td> </td><td> </td></tr><tr><td> </td><td> </td><td> </td></tr><tr><td> </td><td> </td><td> </td></tr><tr><td> </td><td> </td><td> </td></tr></tbody></table>									FROM	TO	PLUGGING MATERIALS	3	0	Cement	15	3	Bentonite	40	15	Gravel / bleach												
FROM	TO	PLUGGING MATERIALS																														
3	0	Cement																														
15	3	Bentonite																														
40	15	Gravel / bleach																														
7	CONTRACTOR'S OF AND OWNER'S CERTIFICATION: This water well was plugged under my jurisdiction and was completed on (mo/day/year) 8/26/03 and this record is true to the best of my knowledge and belief. Kansas Water Well Contractor's License No. 628 This Water Well Record was completed on (mo/day/year) 8/26/03 Under the business name of Interpines by (signature) 																															
INSTRUCTIONS: Use typewriter or ball point pen. Please press firmly and print clearly. Please fill in blanks, underline or circle the correct answers. Send top three copies to Kansas Department of Health and Environment, Bureau of Water, Geology Section, 1000 SW Jackson St., Ste. 420, Topeka, Kansas 66612-1367. Telephone: 785/296-5522. Send one to Water Well Owner and retain one for your records.																																