

CORRECTION(S) TO WATER WELL RECORD (WWC-5)
(to rectify lacking or incorrect information)

Location listed as:

Section-Township-Range: None Given

Fraction ($\frac{1}{4}$ $\frac{1}{4}$ $\frac{1}{4}$): _____

County: Sedgwick

Location changed to:

13-27.5-1W

NE SW SE

Other changes: Initial statements: _____

Changed to: _____

Comments: _____

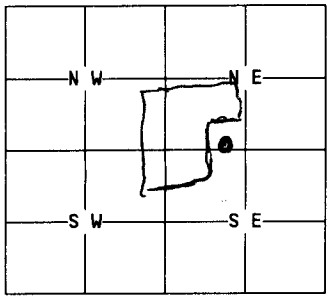
verification method: Well address, city map, and

Wichita West 1:24,000 topo. map.

initials: DRL date: 3/8/2004

submitted by: Kansas Geological Survey, Data Resources Library, 1930 Constant Ave., Lawrence, KS 66047-3726
to: Kansas Dept of Health & Environment, Bureau of Water, 1000 SW Jackson, Suite 420, Topeka, KS 66612-1367.

Received
4-25-03
TW

1 LOCATION OF WATER WELL:	Fraction 1/4 1/4 1/4	Section Number	Township Number	Range Number																											
County: <u>Sedgewick</u>																															
Distance and direction from nearest town or city street address of well, if located within city? <u>776 N. Custer (lot # 104 Sims PARK GARDEN in the city of Wichita)</u>																															
2 WATER WELL OWNER: <u>Bill D. CORZATT + Dorothy MAY CORZATT Sedg. Co. KS.</u>																															
RR#, St. Address, Box #: <u>776 N. Custer</u> Board of Agriculture, Division of Water Resources City, State, ZIP Code: <u>Wichita, Ks. 67203</u> Application Number:																															
3 MARK WELL'S LOCATION WITH AN "X" IN SECTION BOX: N  S		4 DEPTH OF WELL..... <u>31</u>ft. WELL'S STATIC WATER LEVEL..... <u>7</u>ft. WELL WAS USED AS: <table border="0" style="width:100%"><tr><td>1 Domestic</td><td>5 Public Water Supply</td><td>9 Dewatering</td></tr><tr><td>2 Irrigation</td><td>6 Oil Field Water Supply</td><td>10 Monitoring Well</td></tr><tr><td>3 Feedlot</td><td><u>7 Lawn and Garden Only</u></td><td>11 Injection Well</td></tr><tr><td>4 Industrial</td><td>8 Air Conditioning</td><td>12 Other.....</td></tr></table> Was a chemical/bacteriological sample submitted to Department? Yes....No. <u>X</u> If yes, mo/day/yr sample was submitted..... Water Well Disinfected: Yes.. <u>X</u> .. No.....			1 Domestic	5 Public Water Supply	9 Dewatering	2 Irrigation	6 Oil Field Water Supply	10 Monitoring Well	3 Feedlot	<u>7 Lawn and Garden Only</u>	11 Injection Well	4 Industrial	8 Air Conditioning	12 Other.....															
1 Domestic	5 Public Water Supply	9 Dewatering																													
2 Irrigation	6 Oil Field Water Supply	10 Monitoring Well																													
3 Feedlot	<u>7 Lawn and Garden Only</u>	11 Injection Well																													
4 Industrial	8 Air Conditioning	12 Other.....																													
5 TYPE OF BLANK CASING USED: <table border="0" style="width:100%"><tr><td>1 Steel</td><td>3 RMP (SR)</td><td>5 Wrought</td><td>7 Fiberglass</td><td>9 Other (specify below)</td></tr><tr><td><u>2 PVC</u></td><td>4 ABS</td><td>6 Asbestos-Cement</td><td>8 Concrete Tile</td><td></td></tr></table> Blank casing diameter..... <u>5</u>in. Was casing pulled? Yes..... No. <u>X</u> . If yes, how much..... Casing height above or below land surface... <u>4 ft. Below</u>in.					1 Steel	3 RMP (SR)	5 Wrought	7 Fiberglass	9 Other (specify below)	<u>2 PVC</u>	4 ABS	6 Asbestos-Cement	8 Concrete Tile																		
1 Steel	3 RMP (SR)	5 Wrought	7 Fiberglass	9 Other (specify below)																											
<u>2 PVC</u>	4 ABS	6 Asbestos-Cement	8 Concrete Tile																												
6 GROUT PLUG MATERIAL: 1 Neat cement <u>2</u> Cement grout 3 Bentonite 4 Other..... Grout Plug Intervals: From.....ft. to.....ft., From.....ft. to.....ft., From..... to.....ft. What is the nearest source of possible contamination: <table border="0" style="width:100%"><tr><td>1 Septic tank</td><td>6 Seepage pit</td><td>11 Fuel storage</td><td>16 Other (specify below)</td></tr><tr><td><u>2 Sewer lines</u></td><td>7 Pit privy</td><td>12 Fertilizer storage</td><td></td></tr><tr><td>3 Watertight sewer lines</td><td>8 Sewage lagoon</td><td>13 Insecticide storage</td><td></td></tr><tr><td>4 Lateral lines</td><td>9 Feedyard</td><td>14 Abandoned water well</td><td></td></tr><tr><td>5 Cess Pool</td><td>10 Livestock pens</td><td>15 Oil well/Gas well</td><td></td></tr></table> Direction from well? <u>Southeast</u> How many feet? <u>8 1/2 ft.</u>					1 Septic tank	6 Seepage pit	11 Fuel storage	16 Other (specify below)	<u>2 Sewer lines</u>	7 Pit privy	12 Fertilizer storage		3 Watertight sewer lines	8 Sewage lagoon	13 Insecticide storage		4 Lateral lines	9 Feedyard	14 Abandoned water well		5 Cess Pool	10 Livestock pens	15 Oil well/Gas well								
1 Septic tank	6 Seepage pit	11 Fuel storage	16 Other (specify below)																												
<u>2 Sewer lines</u>	7 Pit privy	12 Fertilizer storage																													
3 Watertight sewer lines	8 Sewage lagoon	13 Insecticide storage																													
4 Lateral lines	9 Feedyard	14 Abandoned water well																													
5 Cess Pool	10 Livestock pens	15 Oil well/Gas well																													
<table border="1" style="width:100%"><thead><tr><th>FROM</th><th>TO</th><th>PLUGGING MATERIALS</th></tr></thead><tbody><tr><td><u>31</u></td><td><u>4</u></td><td><u>Cement Grout</u></td></tr><tr><td><u>4</u></td><td><u>0</u></td><td><u>Compacted Soil</u></td></tr><tr><td> </td><td> </td><td> </td></tr><tr><td> </td><td> </td><td> </td></tr><tr><td> </td><td> </td><td> </td></tr><tr><td> </td><td> </td><td> </td></tr><tr><td> </td><td> </td><td> </td></tr><tr><td> </td><td> </td><td> </td></tr></tbody></table>					FROM	TO	PLUGGING MATERIALS	<u>31</u>	<u>4</u>	<u>Cement Grout</u>	<u>4</u>	<u>0</u>	<u>Compacted Soil</u>																		
FROM	TO	PLUGGING MATERIALS																													
<u>31</u>	<u>4</u>	<u>Cement Grout</u>																													
<u>4</u>	<u>0</u>	<u>Compacted Soil</u>																													
7 CONTRACTOR'S OR LANDOWNER'S CERTIFICATION: This water well was plugged under my jurisdiction and was completed on (mo/day/year).... <u>4/22/03</u> and this record is true to the best of my knowledge and belief. Kansas Water Well Contractor's License No. This Water Well Record was completed on (mo/day/year) <u>4/23/03</u> under the business name of by (signature) <u>X Donald D. Fisher</u>																															
INSTRUCTIONS: Use typewriter or ball point pen. Please press firmly and print clearly. Please fill in blanks, underline or circle the correct answers. Send top three copies to Kansas Department of Health and Environment, Bureau of Water, Topeka, Kansas 66620-0001. Telephone: 785/296-3565. Send one to Water Well Owner and retain one for your records.																															