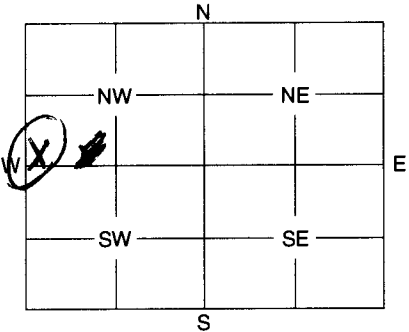


1	LOCATION OF WATER WELL:	Fraction <u>SW SW NW</u> $\frac{1}{4}$ $\frac{1}{4}$ $\frac{1}{4}$	Section Number <u>29</u>	Township Number <u>27S</u>	Range Number <u>1</u> <u>EW</u>
County: <u>Sedgwick</u>					

Distance and direction from nearest town or city street address of well if located within city?

661 Wetmore
City of Wichita

2	WATER WELL OWNER: <u>City of Wichita</u>
RR #, St. Address, Box #: City, State, ZIP Code :	
Board of Agriculture, Division of Water Resources Application Number:	

3	MARK WELL'S LOCATION WITH AN "X" IN SECTION BOX:	4	DEPTH OF WELL <u>147</u> ft. WELL'S STATIC WATER LEVEL <u>11</u> ft. WELL WAS USED AS: 1 Domestic 5 Public Water Supply 9 Dewatering 2 Irrigation 6 Oil Field Water Supply 10 Monitoring Well 3 Feedlot 7 Domestic (Lawn & Garden) 11 Injection Well 4 Industrial 8 Air Conditioning 12 Other _____
		Was a chemical / bacteriological sample submitted to Department? Yes _____ No <u>X</u> If yes, mo/day/yr sample was submitted _____ Water Well Disinfected: Yes <u>X</u> No _____	

5	TYPE OF BLANK CASING USED:
1 <u>Steel</u> 3 RMP (SR) 5 Wrought 7 Fiberglass 9 Other (Specify below) 2 PVC 4 ABS <u>5</u> 6 Asbestos-Cement 8 Concrete Tile Blank casing diameter _____ in. Was casing pulled? Yes _____ No <u>X</u> If yes, how much _____ Casing height above or below land surface <u>30</u> in.	

6	GROUT PLUG MATERIAL: 1 Neat cement 2 Cement grout <u>3 Bentonite</u> 4 Other _____
Grout Plug Intervals: From <u>15</u> ft. to <u>3</u> ft., From _____ ft. to _____ ft., From _____ ft. to _____ ft.	
What is the nearest source of possible contamination:	
1 Septic tank 6 Seepage pit 11 Fuel storage 16 Other (specify below) 2 Sewer lines 7 Pit privy 12 Fertilizer storage 3 Watertight sewer lines 8 Sewage lagoon 13 Insecticide storage 4 Lateral lines 9 Feedyard <u>14 Abandoned water well</u> 5 Cess pool 10 Livestock pens 15 Oil well/Gas well	
Direction from well? _____ How many feet? _____	

FROM	TO	PLUGGING MATERIALS
147	15	gravel
15	3	bentonite
3	0	top soil

7	CONTRACTOR'S OF LANDOWNER'S CERTIFICATION: This water well was plugged under my jurisdiction and was completed on (mo/day/year) <u>12-30-03</u> and this record is true to the best of my knowledge and belief. Kansas Water Well Contractor's License No. <u>318</u> This Water Well Record was completed on (mo/day/year) <u>12-30-03</u> under the business name of <u>Weninger Drilling Inc.</u> by (signature) <u>Michelle Borg</u>
---	---

INSTRUCTIONS: Use typewriter or ball point pen. Please press firmly and print clearly. Please fill in blanks, underline or circle the correct answers. Send top three copies to Kansas Department of Health and Environment, Bureau of Water, Geology Section, 1000 SW Jackson St., Ste. 420, Topeka, Kansas 66612-1367. Telephone: 785/296-5522. Send one to Water Well Owner and retain one for your records.