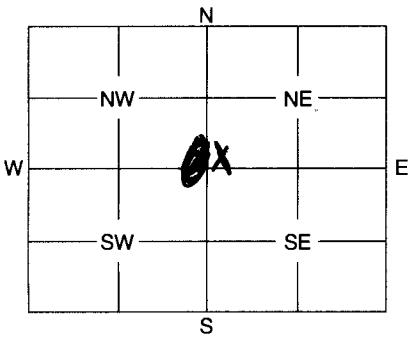


1	LOCATION OF WATER WELL: County: <u>Sedgwick</u>	Fraction <u>SW 1/4</u>	Section Number <u>30</u>	Township Number <u>27</u>	Range Number <u>1</u>
---	--	------------------------	--------------------------	---------------------------	-----------------------

Distance and direction from nearest town or city street address of well if located within city?
1126 Hidden Lakes

2	WATER WELL OWNER: <u>City of Wichita</u>	Board of Agriculture, Division of Water Resources Application Number:
---	--	--

3	MARK WELL'S LOCATION WITH AN "X" IN SECTION BOX: 	4	DEPTH OF WELL <u>133</u> ft. WELL'S STATIC WATER LEVEL <u>10</u> ft. WELL WAS USED AS: ☒ 1 Domestic ☐ 2 Irrigation ☐ 3 Feedlot ☐ 4 Industrial ☐ 5 Public Water Supply ☐ 6 Oil Field Water Supply ☐ 7 Domestic (Lawn & Garden) ☐ 8 Air Conditioning ☐ 9 Dewatering ☐ 10 Monitoring Well ☐ 11 Injection Well ☐ 12 Other Was a chemical / bacteriological sample submitted to Department? Yes ☐ No ☒ If yes, mo/day/yr sample was submitted _____ Water Well Disinfected: Yes ☒ No ☐
---	--	---	---

5	TYPE OF BLANK CASING USED: ☒ 1 Steel ☐ 2 PVC ☐ 3 RMP (SR) ☐ 4 ABS ☐ 5 Wrought ☐ 6 Asbestos-Cement ☐ 7 Fiberglass ☐ 8 Concrete Tile ☐ 9 Other (Specify below) Blank casing diameter _____ in. Was casing pulled? Yes ☐ No ☒ If yes, how much _____ Casing height above or below land surface <u>36</u> in.
---	--

6	GROUT PLUG MATERIAL: ☐ 1 Neat cement ☒ 2 Cement grout ☒ 3 Bentonite ☐ 4 Other Grout Plug Intervals: From <u>15</u> ft. to <u>3</u> ft., From _____ ft. to _____ ft., From _____ ft. to _____ ft. What is the nearest source of possible contamination: ☐ 1 Septic tank ☐ 6 Seepage pit ☐ 11 Fuel storage ☐ 16 Other (specify below) ☐ 2 Sewer lines ☐ 7 Pit privy ☐ 12 Fertilizer storage ☐ 3 Watertight sewer lines ☐ 8 Sewage lagoon ☐ 13 Insecticide storage ☐ 4 Lateral lines ☐ 9 Feedyard ☒ 14 Abandoned water well ☐ 5 Cess pool ☐ 10 Livestock pens ☐ 15 Oil well/Gas well Direction from well? _____ How many feet? _____
---	--

FROM	TO	PLUGGING MATERIALS
133	15	gravel
15	3	bentonite
30		top soil

7	CONTRACTOR'S OF LANDOWNER'S CERTIFICATION: This water well was plugged under my jurisdiction and was completed on (mo/day/year) <u>8-30-03</u> and this record is true to the best of my knowledge and belief. Kansas Water Well Contractor's License No. <u>318</u> This Water Well Record was completed on (mo/day/year) <u>8-30-03</u> under the business name of <u>Weninger Drilling Inc.</u> by (signature) <u>Duke Winger</u>
---	---

INSTRUCTIONS: Use typewriter or ball point pen. Please press firmly and print clearly. Please fill in blanks, underline or circle the correct answers. Send top three copies to Kansas Department of Health and Environment, Bureau of Water, Geology Section, 1000 SW Jackson St., Ste. 420, Topeka, Kansas 66612-1367. Telephone: 785/296-5522. Send one to Water Well Owner and retain one for your records.