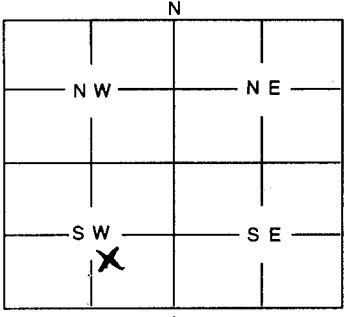


1	LOCATION OF WATER WELL:	Fraction	Section Number	Township Number	Range Number
County:	<u>Sedgwick</u>	<u>NE 1/4 SE 1/4 SW 1/4</u>	<u>3</u>	<u>27S</u>	<u>1W</u>

Distance and direction from nearest town or city street address of well if located within city?
2310 Sand plum Ct, Wichita, KS

2	WATER WELL OWNER: <u>Richard Schielegal</u>	Board of Agriculture, Division of Water Resources
RR #, St. Address, Box #:	<u>2310 Sand plum Ct.</u>	Application Number:
City, State, ZIP Code :	<u>Wichita, KS</u>	

3	MARK WELL'S LOCATION WITH AN "X" IN SECTION BOX:	4	DEPTH OF WELL <u>60</u> ft												
		WELL'S STATIC WATER LEVEL <u>14</u> ft. WELL WAS USED AS: <table border="0"> <tr> <td>1 Domestic</td> <td>5 Public Water Supply</td> <td>9 Dewatering</td> </tr> <tr> <td>2 Irrigation</td> <td>6 <u>Oil Field</u> Water Supply</td> <td>10 Monitoring Well</td> </tr> <tr> <td>3 Feedlot</td> <td>7 <u>Domestic</u> (Lawn & Garden)</td> <td>11 Injection Well</td> </tr> <tr> <td>4 Industrial</td> <td>8 Air Conditioning</td> <td>12 Other</td> </tr> </table>		1 Domestic	5 Public Water Supply	9 Dewatering	2 Irrigation	6 <u>Oil Field</u> Water Supply	10 Monitoring Well	3 Feedlot	7 <u>Domestic</u> (Lawn & Garden)	11 Injection Well	4 Industrial	8 Air Conditioning	12 Other
1 Domestic	5 Public Water Supply	9 Dewatering													
2 Irrigation	6 <u>Oil Field</u> Water Supply	10 Monitoring Well													
3 Feedlot	7 <u>Domestic</u> (Lawn & Garden)	11 Injection Well													
4 Industrial	8 Air Conditioning	12 Other													
Was a chemical / bacteriological sample submitted to Department? Yes No <u>✓</u> If yes, mo/day/yr sample was submitted Water Well Disinfected: Yes <u>✓</u> No															

5	TYPE OF BLANK CASING USED:
1 Steel 2 <u>PVC</u> 3 RMP (SR) 4 ABS 5 Wrought 6 Asbestos-Cement 7 Fiberglass 8 Concrete Tile 9 Other (Specify below)	
Blank casing diameter <u>5</u> in. Casing height above or below land surface <u>4</u> in. <u>below</u>	
Was casing pulled? Yes No <u>✓</u> If yes, how much <u>TOP 4'</u>	

6	GROUT PLUG MATERIAL: 1 Neat cement 2 Cement grout 3 <u>Bentonite</u> 4 Other Grout Plug Intervals: From <u>4</u> ft. to <u>60</u> ft., From ft. to ft., From to ft. What is the nearest source of possible contamination: <table border="0"> <tr> <td>1 <u>Septic tank</u></td> <td>6 Seepage pit</td> <td>11 Fuel storage</td> <td>16 Other (specify below)</td> </tr> <tr> <td>2 <u>Sewer lines</u></td> <td>7 Pit privy</td> <td>12 Fertilizer storage</td> <td></td> </tr> <tr> <td>3 <u>Watertight sewer lines</u></td> <td>8 Sewage lagoon</td> <td>13 Insecticide storage</td> <td></td> </tr> <tr> <td>4 Lateral lines</td> <td>9 Feedyard</td> <td>14 Abandoned water well</td> <td></td> </tr> <tr> <td>5 Cess Pool</td> <td>10 Livestock pens</td> <td>15 Oil well/Gas well</td> <td></td> </tr> </table> Direction from well? <u>East</u> How many feet? <u>4'</u>	1 <u>Septic tank</u>	6 Seepage pit	11 Fuel storage	16 Other (specify below)	2 <u>Sewer lines</u>	7 Pit privy	12 Fertilizer storage		3 <u>Watertight sewer lines</u>	8 Sewage lagoon	13 Insecticide storage		4 Lateral lines	9 Feedyard	14 Abandoned water well		5 Cess Pool	10 Livestock pens	15 Oil well/Gas well	
1 <u>Septic tank</u>	6 Seepage pit	11 Fuel storage	16 Other (specify below)																		
2 <u>Sewer lines</u>	7 Pit privy	12 Fertilizer storage																			
3 <u>Watertight sewer lines</u>	8 Sewage lagoon	13 Insecticide storage																			
4 Lateral lines	9 Feedyard	14 Abandoned water well																			
5 Cess Pool	10 Livestock pens	15 Oil well/Gas well																			

FROM	TO	PLUGGING MATERIALS
<u>4</u>	<u>60</u>	<u>plugged w/ Bentonite</u>
		<u>Top to bottom</u>

7	CONTRACTOR'S OR LANDOWNER'S CERTIFICATION: This water well was plugged under my jurisdiction and was completed on (mo/day/year) <u>4/5/04</u> and this record is true to the best of my knowledge and belief. Kansas Water Well Contractor's License No. <u>611</u> This Water Well Record was completed on (mo/day/year) under the business name of <u>Chase Drilling</u> by (signature) <u>R. Chase</u>
---	---

INSTRUCTIONS: Use typewriter or ball point pen. Please press firmly and print clearly. Please fill in blanks, underline or circle the correct answers. Send top three copies to Kansas Department of Health and Environment, Bureau of Water, Topeka, Kansas 66620-0001. Telephone: 785/296-3565. Send one to Water Well Owner and retain one for your records.