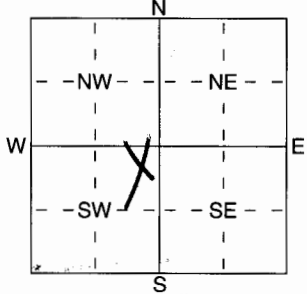


|   |   |
|---|---|
| 1 LOCATION OF WATER WELL: Fraction <u>NE 1/4 NE 1/4 SW 1/4</u> Section Number <u>6</u> Township Number <u>T 270 S</u> Range Number <u>R 10 E/W</u>   |   |
| County: <u>Sedgwick</u> Distance and direction from nearest town or city street address of well if located within city? <u>11013 Greenspoint</u>   |   |
| 2 WATER WELL OWNER: <u>Water-Red</u><br>RR#, St. Address, Box # :<br>City, State, ZIP Code :<br>Board of Agriculture, Division of Water Resources<br>Application Number:   |   |
| 3 LOCATE WELL'S LOCATION WITH AN "X" IN SECTION BOX:<br><div style="text-align: center;">  </div>   | 4 DEPTH OF COMPLETED WELL <u>50</u> ft. ELEVATION: <u>811.04</u><br>Depth(s) Groundwater Encountered: 1 <u>18</u> ft. If yes, mo/day/yr sample was submitted<br>Water Well Disinfected? Yes <u>X</u> No <u>X</u> |
| 5 TYPE OF BLANK CASING USED:<br>1 Steel 3 RMP (SR) 5 Wrought iron 8 Concrete tile CASING JOINTS: Glued <u>X</u> Clamped <u>X</u><br>2 PVC 4 ABS 6 Asbestos-Cement 9 Other (specify below) Welded <u>X</u><br>Blank casing diameter <u>5</u> in. |   |
| 6 GROUT MATERIAL: 3 1 Neat cement 2 Cement grout 3 Bentonite 4 Other <u>18</u><br>Grout Intervals: From <u>3</u> ft. to <u>18</u> ft., From <u>18</u> ft. to <u>50</u> ft., From <u>18</u> ft. to <u>50</u> ft., From <u>18</u> ft. to <u>50</u> ft.<br>What is the nearest source of possible contamination:<br>1 Septic tank 4 Lateral lines 7 Pit privy 10 Livestock pens 14 Abandoned water well<br>2 Sewer lines 5 Cess pool 8 Sewage lagoon 11 Fuel storage 15 Oil well/Gas well<br>3 Watertight sewer lines 6 Seepage pit 9 Feedyard 12 Fertilizer storage 16 Other (specify below)<br>Direction from well? <u>South</u> How many feet? <u>25</u>   |   |
| FROM TO LITHOLOGIC LOG   | FROM TO PLUGGING INTERVALS   |
| 0 3 top soil   |   |
| 3 16 clay   |   |
| 16 50 med sand   |   |
| RECEIVED<br>SEP 07 2004<br>BUREAU OF WATER   |   |
| 7 CONTRACTOR'S OR LANDOWNER'S CERTIFICATION: This water well was (1) constructed, (2) reconstructed, or (3) plugged under my jurisdiction and was completed on (mo/day/year) <u>8-11-04</u> and this record is true to the best of my knowledge and belief. Kansas Water Well Contractor's Licence No. <u>218</u> This Water Well Record was completed on (mo/day/yr) <u>8-11-04</u> under the business name of <u>Werning Drilling Inc</u> by (signature) <u>Quelley</u>   |   |