

1 LOCATION OF WATER WELL:	Fraction	Section Number	Township Number	Range Number
County: <u>Sedgwick</u>	<u>NW 1/4 NW 1/4 SW 1/4</u>	<u>21</u>	T <u>270</u> S	R <u>1</u> E <u>W</u>

Distance and direction from nearest town or city street address of well if located within city?

208. N. Robin

2 WATER WELL OWNER:

RR#, St. Address, Box # :

City, State, ZIP Code :

Joanne Clevenger 801

Board of Agriculture, Division of Water Resources


Application Number:

3 LOCATE WELL'S LOCATION WITH

4 DEPTH OF COMPLETED WELL

ft. ELEVATION:

AN "X" IN SECTION BOX:

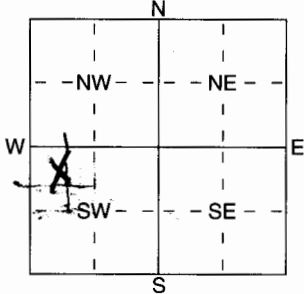

Depth(s) Groundwater Encountered 1 ft. 2 ft. 3 ft.

WELL'S STATIC WATER LEVEL 18 ft. below land surface measured on mo/day/yr 8-30-04

Pump test data: Well water was ft. after hours pumping gpm

Est. Yield 25 gpm: Well water was ft. after hours pumping gpm

WELL WATER TO BE USED AS: 5 Public water supply 8 Air conditioning 11 Injection well

1 Domestic 3 Feedlot 6 Oil field water supply 9 Dewatering 12 Other (Specify below)

2 Irrigation 4 Industrial 7 Domestic (lawn & garden) 10 Monitoring well

Was a chemical/bacteriological sample submitted to Department? Yes No X If yes, mo/day/yr sample was submittedWater Well Disinfected? Yes No

5 TYPE OF BLANK CASING USED:

- 1 Steel
2 PVC
3 RMP (SR)
4 ABS

- 5 Wrought iron
6 Asbestos-Cement
7 Fiberglass

- 8 Concrete tile
9 Other (specify below)

CASING JOINTS: Glued X Clamped

Welded

Threaded

Blank casing diameter in. to ft., Dia in. to ft., Dia in. to ft.

Casing height above land surface 12 in., weight 2.40 lbs./ft. Wall thickness or gauge No. 140 psi

TYPE OF SCREEN OR PERFORATION MATERIAL:

- 1 Steel
2 Brass
3 Stainless Steel
4 Galvanized Steel

- 5 Fiberglass
6 Concrete tile

- 7 PVC
8 RMP (SR)
9 ABS

10 Asbestos-Cement

11 Other (Specify)

12 None used (open hole)

SCREEN OR PERFORATION OPENINGS ARE:

- 1 Continuous slot
2 Louvered shutter
3 Mill slot
4 Key punched

- 5 Gauzed wrapped
6 Wire wrapped
7 Torch cut

8 Saw cut 11 None (open hole)

9 Drilled holes

10 Other (specify) ft.

SCREEN-PERFORATED INTERVALS: From 70' ft. to 80' ft., From ft. to ft.

From ft. to ft., From ft. to ft.

GRAVEL PACK INTERVALS: From 18' ft. to 80' ft., From ft. to ft.

From ft. to ft., From ft. to ft.

6 GROUT MATERIAL:

1 Neat cement

2 Cement grout

3 Bentonite

4 Other

Grout Intervals: From 3 ft. to 18 ft., From ft. to ft., From ft. to ft.

What is the nearest source of possible contamination:

1 Septic tank 4 Lateral lines

2 Sewer lines 5 Cess pool

3 Watertight sewer lines 6 Seepage pit

7 Pit privy

8 Sewage lagoon

9 Feedyard

10 Livestock pens

11 Fuel storage

12 Fertilizer storage

13 Insecticide storage

14 Abandoned water well

15 Oil well/Gas well

16 Other (specify below)

Direction from well? EastHow many feet? 80'

FROM	TO	LITHOLOGIC LOG	FROM	TO	PLUGGING INTERVALS
<u>0</u>	<u>1</u>	<u>Top soil</u>			
<u>1</u>	<u>8</u>	<u>Clay</u>			
<u>8</u>	<u>15</u>	<u>Fine Sand</u>			
<u>15</u>	<u>36</u>	<u>Med Sand</u>			
<u>36</u>	<u>38</u>	<u>Clay</u>			
<u>38</u>	<u>80</u>	<u>Fine / med Sand</u>			

RECEIVED

SEP 07 2004

BUREAU OF WATER

7 CONTRACTOR'S OR LANDOWNER'S CERTIFICATION: This water well was (1) constructed, (2) reconstructed, or (3) plugged under my jurisdiction and was completed on (mo/day/year) 8-30-04

and this record is true to the best of my knowledge and belief. Kansas

Water Well Contractor's Licence No. 38This Water Well Record was completed on (mo/day/yr) 9-1-04under the business name of Weninger Drilling Inc.by (signature) [Signature]