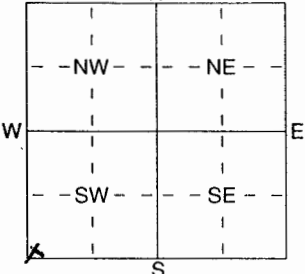


1 LOCATION OF WATER WELL:		Fraction	Section Number	Township Number	Range Number
County: Sedgwick		SW 1/4 SW 1/4 SW 1/4	17	T 27 S	R 1 E/W
Distance and direction from nearest town or city street address of well if located within city? 10330 W. Central Wichita, KS					
2 WATER WELL OWNER: Coastal Mart 2 N. Nevada Colorado Springs, CO 80903					
RR#, St. Address, Box # : City, State, ZIP Code : Board of Agriculture, Division of Water Resource Application Number:					
3 LOCATE WELL'S LOCATION WITH AN "X" IN SECTION BOX:		4 DEPTH OF COMPLETED WELL 32.00 ft. ELEVATION: 1336.77			
		Depth(s) Groundwater Encountered 1 ft. 2 ft. 3 ft. WELL'S STATIC WATER LEVEL 21.77 ft. below land surface measured on mo/day/yr 8/9/2004 Pump test data: Well water was ft. after hours pumping gpr Est. Yield gpm: Well water was ft. after hours pumping gpr WELL WATER TO BE USED AS: 5 Public water supply 8 Air conditioning 11 Injection well 1 Domestic 3 Feedlot 6 Oil field water supply 9 Dewatering 12 Other (Specify below) 2 Irrigation 4 Industrial 7 Domestic (lawn & garden) 10 Monitoring well MW4 Was a chemical/bacteriological sample submitted to Department? Yes No X; If yes, mo/day/yr sample was submitted Water Well Disinfected? Yes No (No)			
5 TYPE OF BLANK CASING USED: 1 Steel 3 RMP (SR) 5 Wrought iron 8 Concrete tile CASING JOINTS: Glued Clamped 2 PVC 4 ABS 7 Fiberglass 9 Other (specify below) Welded Threaded X Blank casing diameter 2" in. to 17' ft., Dia in. to ft., Dia in. to ft. Casing height above land surface flush in., weight lbs./ft. Wall thickness or gauge No. 40 TYPE OF SCREEN OR PERFORATION MATERIAL: 1 Steel 3 Stainless Steel 5 Fiberglass 7 PVC 10 Asbestos-Cement 2 Brass 4 Galvanized Steel 6 Concrete tile 8 RMP (SR) 11 Other (Specify) 9 ABS 12 None used (open hole) SCREEN OR PERFORATION OPENINGS ARE: 1 Continuous slot 3 Mill slot 5 Gauzed wrapped 8 Saw cut 11 None (open hole) 2 Louvered shutter 4 Key punched 6 Wire wrapped 9 Drilled holes 10 Other (specify) SCREEN-PERFORATED INTERVALS: From 17' ft. to 32' ft., From ft. to ft. GRAVEL PACK INTERVALS: From 15' ft. to 32' ft., From ft. to ft. 6 GROUT MATERIAL: 1 Neat cement 2 Cement grout 3 Bentonite 4 Other Cement Grout Intervals: From ft. to ft., From 1' ft. to 15' ft., From ft. to ft. What is the nearest source of possible contamination: 1 Septic tank 4 Lateral lines 7 Pit privy 10 Livestock pens 14 Abandoned water well 2 Sewer lines 5 Cess pool 8 Sewage lagoon 11 Fuel storage 15 Oil well/Gas well 3 Watertight sewer lines 6 Seepage pit 9 Feedyard 12 Fertilizer storage 16 Other (specify below) Direction from well? North of well 13 Insecticide storage, Contaminated site How many feet? 15'					
FROM TO LITHOLOGIC LOG FROM TO PLUGGING INTERVALS					
0	2	Cement			
2	8	Clay, sandy, red brown, soft			
8	13	Clay, sand, olive-gray, stiff			
13	17	Clay, fine sand, dk red brown			
17	23	Clay, sand, red brown			
23	27	Clay, gtz sand and, soft			
27	32	Clay, sand, gray, dk tan			

RECEIVED

SEP 10 2004

BUREAU OF WATER

7 CONTRACTOR'S OR LANDOWNER'S CERTIFICATION: This water well was (1) constructed, (2) reconstructed, or (3) plugged under my jurisdiction and we completed on (mo/day/year) 8/2/2004 and this record is true to the best of my knowledge and belief. Kansas Water Well Contractor's Licence No 705 This Water Well Record was completed on (mo/day/yr) 8/23/2004 under the business name of Handex by (signature) [Signature]