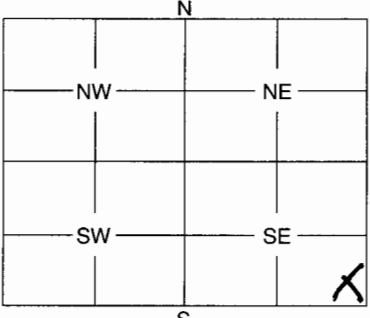


1	LOCATION OF WATER WELL: County: SEDGWICK SE ¼ SE ¼ SE ¼	Fraction 30	Section Number 30	Township Number T27S	Range Number R1W E/W																								
Distance and direction from nearest town or city street address of well if located within city? SE corner of basement - 1411 S. Maize Rd Wichita KS 67212																													
2	WATER WELL OWNER: Kris Wilson RR #, St. Address, Box #: 1411 S. Maize Rd City, State, ZIP Code: Wichita KS 67212 Board of Agriculture, Division of Water Resources Application Number: UNKNOWN																												
3	MARK WELL'S LOCATION WITH AN "X" IN SECTION BOX: 																												
4	DEPTH OF WELL 50 ft. WELL'S STATIC WATER LEVEL 20 ft. WELL WAS USED AS: 1 Domestic 2 Irrigation 3 Feedlot 4 Industrial 5 Public Water Supply 6 Oil Field Water Supply <u>7 Domestic (Lawn & Garden)</u> 8 Air Conditioning 9 Dewatering 10 Monitoring Well 11 Injection Well 12 Other Was a chemical / bacteriological sample submitted to Department? Yes No X If yes, mo/day/yr sample was submitted Water Well Disinfected: Yes X No																												
5	TYPE OF BLANK CASING USED: <u>1 Steel</u> 2 PVC 3 RMP (SR) 4 ABS 5 Wrought 6 Asbestos-Cement 7 Fiberglass 8 Concrete Tile 9 Other (Specify below) Blank casing diameter 8 in. Was casing pulled? Yes No X If yes, how much Casing height above or below land surface 0 in.																												
6	GROUT PLUG MATERIAL: 1 Neat cement <u>2 Cement grout</u> <u>3 Bentonite</u> 4 Other Grout Plug Intervals: From 15 ft. to 6 ft., From 6 ft. to 0 ft., From to ft. What is the nearest source of possible contamination: 1 Septic tank 2 Sewer lines 3 Watertight sewer lines 4 Lateral lines 5 Cess pool 6 Seepage pit 7 Pit privy 8 Sewage lagoon 9 Feedyard 10 Livestock pens 11 Fuel storage 12 Fertilizer storage 13 Insecticide storage 14 Abandoned water well 15 Oil well/Gas well <u>16 Other (specify below)</u> Sump pump Direction from well? South East How many feet? 2																												
<table border="1" style="width:100%; border-collapse: collapse;"> <thead> <tr> <th style="width:15%;">FROM</th> <th style="width:15%;">TO</th> <th style="width:70%;">PLUGGING MATERIALS</th> </tr> </thead> <tbody> <tr> <td>6</td> <td>0</td> <td>Cement</td> </tr> <tr> <td>15</td> <td>6</td> <td>Bentonite</td> </tr> <tr> <td>50</td> <td>15</td> <td>Sand / bleach</td> </tr> <tr><td> </td><td> </td><td> </td></tr> <tr><td> </td><td> </td><td> </td></tr> <tr><td> </td><td> </td><td> </td></tr> <tr><td> </td><td> </td><td> </td></tr> </tbody> </table>						FROM	TO	PLUGGING MATERIALS	6	0	Cement	15	6	Bentonite	50	15	Sand / bleach												
FROM	TO	PLUGGING MATERIALS																											
6	0	Cement																											
15	6	Bentonite																											
50	15	Sand / bleach																											
7	CONTRACTOR'S OF LANDOWNER'S CERTIFICATION: This water well was plugged under my jurisdiction and was completed on (mo/day/year) 10/20/04 and this record is true to the best of my knowledge and belief. Kansas Water Well Contractor's License No. 628 This Water Well Record was completed on (mo/day/year) 10/20/04 under the business name of JME Enterprises by (signature) <i>[Signature]</i>																												
INSTRUCTIONS: Use typewriter or ball point pen. Please press firmly and print clearly. Please fill in blanks, underline or circle the correct answers. Send top three copies to Kansas Department of Health and Environment, Bureau of Water, Geology Section, 1000 SW Jackson St., Ste. 420, Topeka, Kansas 66612-1367. Telephone: 785/296-5522. Send one to Water Well Owner and retain one for your records.																													

RECEIVED
NOV 10 2004
BUREAU OF WATER