

1	LOCATION OF WATER WELL: County: Sedgwick	Fraction SW $\frac{1}{4}$ NW $\frac{1}{4}$ NW $\frac{1}{4}$	Section Number 25	Township Number 27	Range Number 1
---	--	--	-----------------------------	------------------------------	--------------------------


Distance and direction from nearest town or city street address of well if located within city?

325 S. West, Wichita, Ks

WEST

2	WATER WELL OWNER: Star Lumber
RR #, St. Address, Box #: 325 S. West	
City, State, ZIP Code: Wichita, Ks	
Board of Agriculture, Division of Water Resources Application Number:	

3	MARK WELL'S LOCATION WITH AN "X" IN SECTION BOX:	4	DEPTH OF WELL 22.38 ft. WELL'S STATIC WATER LEVEL 17.27 ft. WELL WAS USED AS: 1 Domestic 2 Irrigation 3 Feedlot 4 Industrial 5 Public Water Supply 6 Oil Field Water Supply 7 Domestic (Lawn & Garden) 8 Air Conditioning 9 Dewatering 10 Monitoring Well 11 Injection Well 12 Other
---	--	---	--

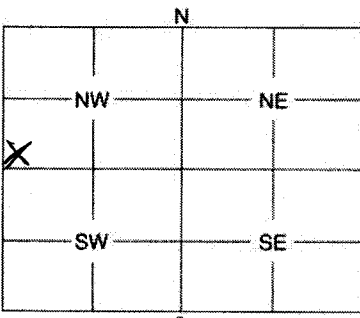

Was a chemical / bacteriological sample submitted to Department? Yes No **X**.....
If yes, mo/day/yr sample was submitted

Water Well Disinfected: Yes No **X**.....

5	TYPE OF BLANK CASING USED:
1 Steel 3 RMP (SR) 5 Wrought 7 Fiberglass 9 Other (Specify below) 2 PVC 4 ABS 6 Asbestos-Cement 8 Concrete Tile	
Blank casing diameter 2 in. Was casing pulled? Yes X No If yes, how much 20'	
Casing height above or below land surface in.	

6	GROUT PLUG MATERIAL: 3 Neat cement 2 Cement grout 3 Bentonite 4 Other surface silts/clays
Grout Plug Intervals: From 20 ft. to 3 ft., From 3 ft. to 0 ft., From to ft.	
What is the nearest source of possible contamination:	
1 Septic tank 6 Seepage pit 11 Fuel storage 16 Other (specify below) cont. silts 2 Sewer lines 7 Pit privy 12 Fertilizer storage 3 Watertight sewer lines 8 Sewage lagoon 13 Insecticide storage 4 Lateral lines 9 Feedyard 14 Abandoned water well 5 Cess pool 10 Livestock pens 15 Oil well/Gas well	
Direction from well? How many feet?	

FROM	TO	PLUGGING MATERIALS
0	3	Surface Silt and Clays
20	3	Bentonite

7	CONTRACTOR'S OF LANDOWNER'S CERTIFICATION: This water well was plugged under my jurisdiction and was completed on (mo/day/year) 11/15/04 and this record is true to the best of my knowledge and belief. Kansas Water Well Contractor's License No. 585 This Water Well Record was completed on (mo/day/year) 10/27/04 under the business name of Associated Environmental, Inc. by (signature) Darin Duncan
---	--

INSTRUCTIONS: Use typewriter or ball point pen. Please press firmly and print clearly. Please fill in blanks, underline or circle the correct answers. Send top three copies to Kansas Department of Health and Environment, Bureau of Water, Geology Section, 1000 SW Jackson St., Ste. 420, Topeka, Kansas 66612-1367. Telephone: 785/296-5522. Send one to Water Well Owner and retain one for your records.