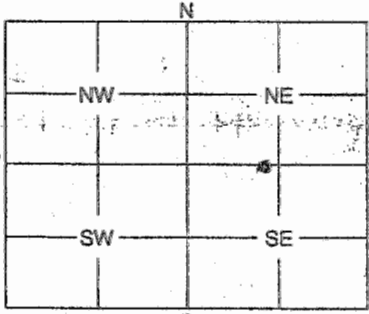


1 LOCATION OF WATER WELL: Fraction Section Number Township Number Range Number
 County: Sedgwick SE 1/4 SE 1/4 NW 1/4 17 27 1W EW

Distance and direction from nearest town or city street address of well if located within city?

10017 Harvest Lane

2 WATER WELL OWNER: A. Maurice Ediger
 RR #, St. Address, Box #: 10017 Harvest
 City, State, ZIP Code: Wichita, KS. 67212
 Board of Agriculture, Division of Water Resources
 Application Number: _____

3 MARK WELL'S LOCATION WITH AN "X" IN SECTION BOX:

 4 DEPTH OF WELL 52 ft.
 WELL'S STATIC WATER LEVEL 1.5 ft.
 WELL WAS USED AS:
 1 Domestic 5 Public Water Supply 9 Dewatering
 2 Irrigation 6 Oil Field Water Supply 10 Monitoring Well
 3 Feedlot 7 Domestic (Lawn & Garden) 11 Injection Well
 4 Industrial 8 Air Conditioning 12 Other Water yard but never used
 Was a chemical / bacteriological sample submitted to Department? Yes _____ No ☒
 If yes, mo/day/yr sample was submitted _____
 Water Well Disinfected: Yes _____ No ☒

5 TYPE OF BLANK CASING USED:
 1 Steel 3 RMP (SR) 5 Wrought 7 Fiberglass 9 Other (Specify below)
 2 PVC 4 ABS 6 Asbestos-Cement 8 Concrete Tile
 Blank casing diameter 5 in. Was casing pulled? Yes _____ No ☒ If yes, how much _____
 Casing height above or below land surface 3.5 ft. below in.

6 GROUT PLUG MATERIAL: 1 Neat cement 2 Cement grout 3 Bentonite 4 Other _____
 Grout Plug Intervals: From 52 ft. to 3 ft. From _____ ft. to _____ ft. From _____ ft. to _____ ft.
 What is the nearest source of possible contamination:
 1 Septic tank 6 Seepage pit 11 Fuel storage 12 Fertilizer storage 13 Insecticide storage 14 Abandoned water well 15 Oil well/Gas well
 2 Sewer lines 7 Pit privy 12 Other (specify below) Treated water 20+ years ago
 3 Watertight sewer lines 8 Sewage lagoon
 4 Lateral lines 9 Feedyard
 5 Cess pool 10 Livestock pens
 Direction from well? South How many feet? 12

FROM	TO	PLUGGING MATERIALS
<u>49</u>	<u>0</u>	<u>Bentonite</u>
<u>3</u>	<u>0</u>	<u>Top Soil</u>

7 CONTRACTOR'S OF LANDOWNER'S CERTIFICATION: This water well was plugged under my jurisdiction and was completed on (mo/day/year) 2-26-05 and this record is true to the best of my knowledge and belief. Kansas Water Well Contractor's License No. N/A This Water Well Record was completed on (mo/day/year) 2-26-05 under the business name of A. Maurice Ediger by (signature) A. Maurice Ediger

INSTRUCTIONS: Use typewriter or ball point pen. Please press firmly and print clearly. Please fill in blanks; underline or circle the correct answers. Send top three copies to Kansas Department of Health and Environment, Bureau of Water, Geology Section, 1000 SW Jackson St., Ste. 420, Topeka, Kansas 66612-1367. Telephone: 785/296-5522. Send one to Water Well Owner and retain one for your records.

RECEIVED
 MAR 07 2005
 BUREAU OF WATER