


1 LOCATION OF WATER WELL:	Fraction	Section Number	Township Number	Range Number
County: <u>Sedgwick</u>	<u>NE 1/4 SW 1/4 NW 1/4</u>	<u>8</u>	T <u>27</u> S <u>0</u>	R <u>1</u> E <u>W</u>

Distance and direction from nearest town or city street address of well if located within city?

10105 Bella Vista, Wichita, KS

2 WATER WELL OWNER:	Board of Agriculture, Division of Water Resources
RR#, St. Address, Box # : <u>10105 Bella Vista</u>	Application Number:
City, State, ZIP Code : <u>Wichita, KS</u>	

3 LOCATE WELL'S LOCATION WITH AN "X" IN SECTION BOX:	4 DEPTH OF COMPLETED WELL <u>60</u> ft. ELEVATION:
--	--

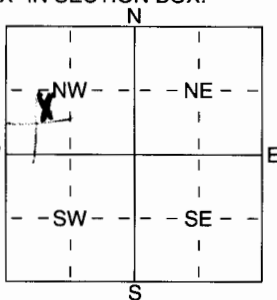

Depth(s) Groundwater Encountered <u>1</u> ft. 2 ft. 3 ft.
WELL'S STATIC WATER LEVEL <u>24</u> ft. below land surface measured on mo/day/yr
Pump test data: Well water was ft. after hours pumping gpm
Est. Yield gpm: Well water was ft. after hours pumping gpm
WELL WATER TO BE USED AS:
1 Domestic 3 Feedlot 5 Public water supply 8 Air conditioning 11 Injection well
2 Irrigation 4 Industrial 6 Oil field water supply 9 Dewatering 12 Other (Specify below)
7 Domestic (lawn & garden) 10 Monitoring well

Was a chemical/bacteriological sample submitted to Department? Yes No ☒; If yes, mo/day/yr sample was submitted
 Water Well Disinfected? Yes ☒ No

5 TYPE OF BLANK CASING USED:	5 Wrought iron	8 Concrete tile	CASING JOINTS: Glued ☒ Clamped
1 Steel	6 Asbestos-Cement	9 Other (specify below)	Welded
2 PVC	7 Fiberglass		Threaded
3 RMP (SR)			
4 ABS			

Blank casing diameter 5 in. to 6 ft., Dia 160 in. to ft., Dia in. to ft.Casing height above land surface 16 in., weight 160 lbs./ft. Wall thickness or gauge No.

TYPE OF SCREEN OR PERFORATION MATERIAL:	5 Fiberglass	8 RMP (SR)	10 Asbestos-Cement
1 Steel	6 Concrete tile	9 ABS	11 Other (Specify)
2 Brass			12 None used (open hole)
3 Stainless Steel			
4 Galvanized Steel			

SCREEN OR PERFORATION OPENINGS ARE:	5 Gauzed wrapped	8 Saw cut	11 None (open hole)
1 Continuous slot	6 Wire wrapped	9 Drilled holes	
2 Louvered shutter	7 Torch cut	10 Other (specify)	ft.
3 Mill slot			
4 Key punched			

SCREEN-PERFORATED INTERVALS: From 50 ft. to 60 ft., From ft. to ft.GRAVEL PACK INTERVALS: From 24 ft. to 60 ft., From ft. to ft.

From ft. to ft., From ft. to ft.

6 GROUT MATERIAL:	1 Neat cement	2 Cement grout	3 Bentonite	4 Other
-------------------	---------------	----------------	-------------	---------

Grout Intervals: From 4 ft. to 24 ft., From ft. to ft., From ft. to ft.

What is the nearest source of possible contamination:

1 Septic tank	4 Lateral lines	7 Pit privy	10 Livestock pens	14 Abandoned water well
2 Sewer lines	5 Cess pool	8 Sewage lagoon	11 Fuel storage	15 Oil well/Gas well
3 Watertight sewer lines	6 Seepage pit	9 Feedyard	12 Fertilizer storage	16 Other (specify below)
			13 Insecticide storage	

Direction from well? South West How many feet? 19

FROM	TO	LITHOLOGIC LOG	FROM	TO	PLUGGING INTERVALS
------	----	----------------	------	----	--------------------

FROM 0 TO 2 Top SoilFROM 2 TO 17 Brown ClayFROM 17 TO 41 Med SandFROM 41 TO 44 TAN ClayFROM 44 TO 60 Med Coarse Sand & Gravel

7 CONTRACTOR'S OR LANDOWNER'S CERTIFICATION: This water well was (1) constructed, (2) reconstructed, or (3) plugged under my jurisdiction and was completed on (mo/day/year) <u>11-12-04</u> and this record is true to the best of my knowledge and belief. Kansas Water Well Contractor's Licence No. <u>611</u> This Water Well Record was completed on (mo/day/yr) <u>2-18-05</u> under the business name of <u>Chase Drilling</u> by (signature) <u>D. Chase</u>
