


1 LOCATION OF WATER WELL:	Fraction	Section Number	Township Number	Range Number
County: Sedgwick	$\frac{1}{4}$ NE $\frac{1}{4}$ NE $\frac{1}{4}$ NE	14	T 27 S	R 1 E W

Distance and direction from nearest town or city street address of well if located within city?

1101 N. Dougherty Wichita, KS 672122 WATER WELL OWNER: **Wichita Public Schools**RR#, St. Address, Box # : **1101 N. Dougherty**
City, State, ZIP Code : **Wichita, KS 67212**Board of Agriculture, Division of Water Resources
Application Number:3 LOCATE WELL'S LOCATION WITH 4 DEPTH OF COMPLETED WELL **50** ft. ELEVATION:

AN "X" IN SECTION BOX:

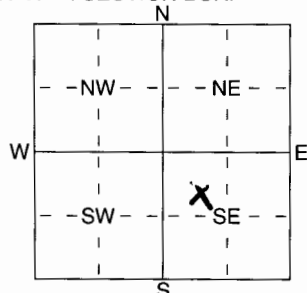

Depth(s) Groundwater Encountered 1 ft. 2 ft. 3 ft.

WELL'S STATIC WATER LEVEL **10** ft. below land surface measured on mo/day/yr **2-4-05**

Pump test data: Well water was ft. after hours pumping gpm

Est. Yield **30** gpm: Well water was ft. after hours pumping gpm

WELL WATER TO BE USED AS: 5 Public water supply 8 Air conditioning 11 Injection well

1 Domestic 3 Feedlot 6 Oil field water supply 9 Dewatering 12 Other (Specify below)

2 Irrigation 4 Industrial **7** Domestic (lawn & garden) 10 Monitoring wellWas a chemical/bacteriological sample submitted to Department? Yes No **X** If yes, mo/day/yr sample was submitted
Water Well Disinfected? **Yes** No

5 TYPE OF BLANK CASING USED:

1 Steel 3 RMP (SR) 5 Wrought iron 8 Concrete tile CASING JOINTS: Glued **X** Clamped
2 PVC 4 ABS 6 Asbestos-Cement 9 Other (specify below) Welded
7 Fiberglass ThreadedBlank casing diameter **5** in. to **40** ft. Dia **12** in. to ft. Dia in. to ft.Casing height above land surface in., weight **2.40** lbs./ft. Wall thickness or gauge No. **160 psi**

TYPE OF SCREEN OR PERFORATION MATERIAL:

1 Steel 3 Stainless Steel 5 Fiberglass **7** PVC 10 Asbestos-Cement
2 Brass 4 Galvanized Steel 6 Concrete tile 8 RMP (SR) 11 Other (Specify)
9 ABS 12 None used (open hole)

SCREEN OR PERFORATION OPENINGS ARE:

1 Continuous slot **3** Mill slot 5 Gauzed wrapped 8 Saw cut 11 None (open hole)
2 Louvered shutter 4 Key punched 6 Wire wrapped 9 Drilled holes
7 Torch cut 10 Other (specify) ft.SCREEN-PERFORATED INTERVALS: From **40** ft. to **50** ft. From ft. to ft.GRAVEL PACK INTERVALS: From **10** ft. to **50** ft. From ft. to ft.

From ft. to ft. From ft. to ft.

6 GROUT MATERIAL: 1 Neat cement 2 Cement grout **3** Bentonite 4 OtherGrout Intervals: From **3** ft. to **10** ft. From ft. to ft. From ft. to ft.

What is the nearest source of possible contamination:

1 Septic tank 4 Lateral lines 7 Pit privy 10 Livestock pens 14 Abandoned water well
2 Sewer lines 5 Cess pool 8 Sewage lagoon 11 Fuel storage 15 Oil well/Gas well
3 Watertight sewer lines 6 Seepage pit 9 Feedyard 12 Fertilizer storage 16 Other (specify below)
13 Insecticide storageDirection from well? **80 EAST** How many feet? **80**

FROM	TO	LITHOLOGIC LOG	FROM	TO	PLUGGING INTERVALS
0	1	Topsoil			
1	4	Clay			
4	10	Fine Sand			
10	25	Med Sand			
25	30	Fine Sand			
30	50	Med Sand			

7 CONTRACTOR'S OR LANDOWNER'S CERTIFICATION: This water well was **1** constructed, (2) reconstructed, or (3) plugged under my jurisdiction and wascompleted on (mo/day/year) **2-4-05** and this record is true to the best of my knowledge and belief. KansasWater Well Contractor's Licence No **318** This Water Well Record was completed on (mo/day/yr) **2-4-05**under the business name of **Weninger Drilling Inc.** by (signature) **Shelley Weninger**