


1827 n High

RR#, St. Address, Box # : 1827 N Hines
City, State, ZIP Code : Wichita KS 67203
Application Number: none

Was a chemical/bacteriological sample submitted to Department? Yes No ☒; If yes, mo/day/hrs sample was submitted
Water Well Disinfected? Yes No ☒

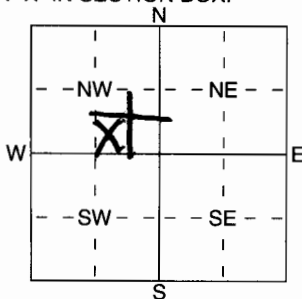

GRAVEL PACK INTERVALS:

Direction from well? *South* How many feet? *12*

[illegible]

under the business name of Beardsley Pump & Well by (signature) [Signature]