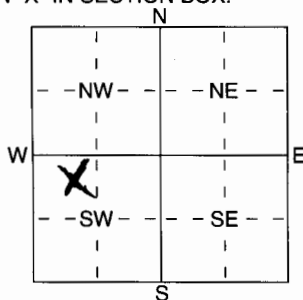


1 LOCATION OF WATER WELL: County: <u>SEBOWICK</u> Fraction: <u>NE 1/4 SW 1/4</u> Section Number: <u>8</u> Township Number: <u>T 27 S</u> Range Number: <u>R 1 E</u>

Distance and direction from nearest town or city street address of well if located within city?

1640 N. MAIZE RD. WICHITA, KS 67212

2 WATER WELL OWNER: RESURRECTION CEMETERYRR#, St. Address, Box # : 1640 N. MAIZE RD.
City, State, ZIP Code : WICHITA, KS 67212Board of Agriculture, Division of Water Resources
Application Number:3 LOCATE WELL'S LOCATION WITH AN "X" IN SECTION BOX: 4 DEPTH OF COMPLETED WELL: 5.0 ft. ELEVATION:

Depth(s) Groundwater Encountered 1 ft. 2 ft. 3 ft.
 WELL'S STATIC WATER LEVEL 25 ft. below land surface measured on mo/day/yr
 Pump test data: Well water was ft. after hours pumping gpm
 Est. Yield 25 gpm: Well water was ft. after hours pumping gpm
 WELL WATER TO BE USED AS: 5 Public water supply 8 Air conditioning 11 Injection well
 1 Domestic 3 Feedlot 6 Oil field water supply 9 Dewatering 12 Other (Specify below)
 2 Irrigation 4 Industrial 7 Domestic (lawn & garden) 10 Monitoring well

Was a chemical/bacteriological sample submitted to Department? Yes No X; If yes, mo/day/yr sample was submitted
 Water Well Disinfected Yes No

5 TYPE OF BLANK CASING USED: 5 Wrought iron 8 Concrete tile CASING JOINTS: Glued X Clamped

1 Steel 3 RMP (SR) 6 Asbestos-Cement 9 Other (specify below) Welded
 2 PVC 4 ABS 7 Fiberglass Threaded

Blank casing diameter 5 1/2 in. to 40 ft. Dia in. to ft. Dia in. to ft.Casing height above land surface 12 in., weight 2.40 lbs./ft. Wall thickness or gauge No. 160 RSE

TYPE OF SCREEN OR PERFORATION MATERIAL:

1 Steel 3 Stainless Steel 5 Fiberglass 8 RMP (SR) 10 Asbestos-Cement
 2 Brass 4 Galvanized Steel 6 Concrete tile 9 ABS 11 Other (Specify)
 12 None used (open hole)

SCREEN OR PERFORATION OPENINGS ARE:

1 Continuous slot 3 Mill slot 5 Gauzed wrapped 8 Saw cut 11 None (open hole)
 2 Louvered shutter 4 Key punched 6 Wire wrapped 9 Drilled holes
 7 Torch cut 10 Other (specify) ft.

SCREEN-PERFORATED INTERVALS: From 40 ft. to 50 ft. From ft. to ft.

From ft. to ft. From ft. to ft.

GRAVEL PACK INTERVALS: From 20 ft. to 50 ft. From ft. to ft.

From ft. to ft. From ft. to ft.

6 GROUT MATERIAL: 1 Neat cement 2 Cement grout 3 Bentonite 4 Other

Grout Intervals: From 3 ft. to 20 ft. From ft. to ft. From ft. to ft.

What is the nearest source of possible contamination:

1 Septic tank 4 Lateral lines 7 Pit privy 10 Livestock pens 14 Abandoned water well
 2 Sewer lines 5 Cess pool 8 Sewage lagoon 11 Fuel storage 15 Oil well/Gas well
 3 Watertight sewer lines 6 Seepage pit 9 Feedyard 12 Fertilizer storage 16 Other (specify below)
 13 Insecticide storage

Direction from well? EAST How many feet? 25

FROM TO LITHOLOGIC LOG FROM TO PLUGGING INTERVALS

0 1 TOP SOIL

1 10 CLAY

10 35 FINE SAND

35 50 MEDIUM SAND