


1	LOCATION OF WATER WELL:	Fraction	Section Number	Township Number	Range Number
County:	<i>Sedawick</i>	<i>SE 1/4 NW 1/4 NW 1/4</i>	<i>13</i>	T <i>27</i> (S)	R <i>1</i> EW (S)

Distance and direction from nearest town or city street address of well if located within city?

2 WATER WELL OWNER: *Dean Reece*
RR#, St. Address, Box # : *1248 N. High*
City, State, ZIP Code : *Wichita, KS*

Board of Agriculture, Division of Water Resources
Application Number:

3	LOCATE WELL'S LOCATION WITH	4	DEPTH OF COMPLETED WELL 70 ft. ELEVATION:
---	-----------------------------	---	---

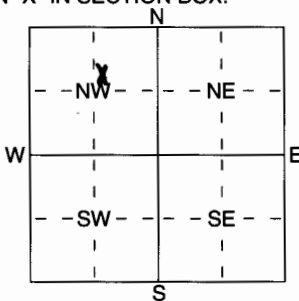

Depth(s) Groundwater Encountered ft. 2 ft. 3 ft.
WELL'S STATIC WATER LEVEL 17 ft. below land surface measured on mo/day/yr
Pump test data: Well water was ft. after hours pumping gpm
Est. Yield gpm: Well water was ft. after hours pumping gpm
WELL WATER TO BE USED AS:

1 Domestic	3 Feedlot	6 <u>Oil field water supply</u>	8 Air conditioning	11 Injection well
2 Irrigation	4 Industrial	7 <u>Domestic (lawn & garden)</u>	9 Dewatering	12 Other (Specify below)
		10 Monitoring well		

Was a chemical/bacteriological sample submitted to Department? Yes No; If yes, mo/day/lys sample was submitted
Water Well Disinfected? Yes No

5	TYPE OF BLANK CASING USED:			CASING JOINTS:	
	1 Steel	3 RMP (SR)	5 Wrought iron	8 Concrete tile	Glued ☒ Clamped ☐
	2 PVC	4 ABS	6 Asbestos-Cement	9 Other (specify below)	Welded ☐
			7 Fiberglass		Threaded ☐

Blank casing diameter 3 in. to 40 ft. Dia in. to ft. Dia in. to ft.
Casing height above land surface 12 in., weight 160 lbs./ft. Wall thickness or gauge No. 270

TYPE OF SCREEN OR PERFORATION MATERIAL:

1 Steel	3 Stainless Steel	5 Fiberglass	7 <u>PVC</u>	10 Asbestos-Cement
2 Brass	4 Galvanized Steel	6 Concrete tile	8 RMP (SR)	11 Other (Specify)
			9 ABS	12 None used (open hole)

SCREEN OR PERFORATION OPENINGS ARE:

1 Continuous slot	3 <u>Mill slot</u>	5 Guazed wrapped	8 Saw cut	11 None (open hole)
2 Louvered shutter	4 Key punched	6 Wire wrapped	9 Drilled holes	
		7 Torch cut	10 Other (specify)	ft.

SCREEN-PERFORATED INTERVALS: From 30 ft. to 70 ft., From ft. to ft.
From ft. to ft., From ft. to ft.
GRAVEL PACK INTERVALS: From 25 ft. to 40 ft., From ft. to ft.
From ft. to ft., From ft. to ft.

6 GROUT MATERIAL: 1 Neat cement 2 Cement grout 3 Bentonite 4 Other.....
Grout Intervals: From 4 ft. to 34 ft., From ft. to ft., From ft. to ft.

What is the nearest source of possible contamination:

1 Septic tank	4 Lateral lines	7 Pit privy	10 Livestock pens	14 Abandoned water well
2 Sewer lines	5 Cess pool	8 Sewage lagoon	11 Fuel storage	15 Oil well/Gas well
3 Watertight sewer lines	6 Seepage pit	9 Feedyard	12 Fertilizer storage	16 Other (specify below)
			13 Insecticide storage	

Direction from well? 1125L How many feet? 16

[illegible]

7 CONTRACTOR'S OR LANDOWNER'S CERTIFICATION: This water well was (1) constructed, (2) reconstructed, or (3) plugged under my jurisdiction and was completed on (mo/day/year) 6-16-06 and this record is true to the best of my knowledge and belief. Kansas Water Well Contractor's Licence No. 6611 This Water Well Record was completed on (mo/day/yr) 9-26-06 under the business name of Chase Drilling by (signature) D. Chase