

1	LOCATION OF WATER WELL:	Fraction <i>SW SW NW</i> <i>1/4 1/4 1/4</i>	Section Number 13	Township Number 27	Range Number 1
---	-------------------------	---	----------------------	-----------------------	-------------------

County: Sedgwick

Distance and direction from nearest town or city street address of well if located within city?

1108 N West St., Wichita, KS

2 WATER WELL OWNER: Brian Thompson


RR #, St. Address, Box #- 1108 N West St.

City, State, ZIP Code Wichita, KS 67203

Board of Agriculture, Division of Water Resources

Application Number:

3 MARK WELL'S LOCATION WITH AN "X" IN SECTION BOX:

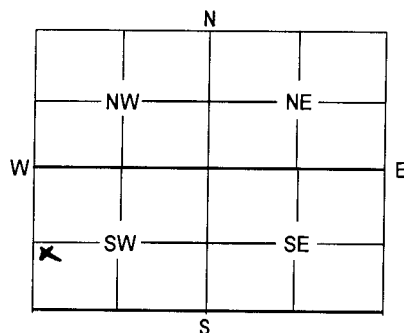

4 DEPTH OF WELL 16.31 ft.

WELL'S STATIC WATER LEVEL 999 ft.

WELL WAS USED AS:

1 Domestic

2 Irrigation

3 Feedlot

4 Industrial

5 Public Water Supply

6 Oil Field Water Supply

7 Domestic (Lawn & Garden)

8 Air Conditioning

9 Dewatering

10 Monitoring Well

11 Injection Well

12 Other

Was a chemical / bacteriological sample submitted to Department? Yes No ☒ X
if yes, mo/day/yr sample was submittedWater Well Disinfected: Yes No ☒ X

5 TYPE OF BLANK CASING USED:

1 Steel
☒ PVC3 RMP (SR)
4 ABS

5 Wrought

6 Asbestos-Cement

7 Fiberglass

8 Concrete Tile

9 Other (Specify below)

Blank casing diameter 2 in. Was casing pulled? Yes ☒ X No If yes, how much All

Casing height above or below land surface in.

6 GROUT PLUG MATERIAL: 1 Neat cement 2 Cement grout ☒ Bentonite 4 Other

Grout Plug Intervals: From 16.31 ft. to 0 ft., From ft. to ft., From ft. to ft.

What is the nearest source of possible contamination:

1 Septic tank

2 Sewer lines

3 Watertight sewer lines

4 Lateral lines

5 Cess pool

6 Seepage pit

7 Pit privy

8 Sewage lagoon

9 Feedyard

10 Livestock pens

11 Fuel storage

12 Fertilizer storage

13 Insecticide storage

14 Abandoned water well

15 Oil well/Gas well

16 Other (specify below)

Direction from well? 999 How many feet? 999

FROM	TO	PLUGGING MATERIALS
16.31	0	3/8 Bentonite chips
		MW-4

7 CONTRACTOR'S OF LANDOWNER'S CERTIFICATION: This water well was plugged under my jurisdiction and was completed on (mo/day/year) 9-21-06 and this record is true to the best of my knowledge and belief. Kansas Water Well Contractor's License No. 665 This Water Well Record was completed on (mo/day/year) 9-30-06 under the business name of Matt Well Environmental

by (signature) *John E. Bell*

INSTRUCTIONS: Use typewriter or ball point pen. Please press firmly and print clearly. Please fill in blanks, underline or circle the correct answers. Send top three copies to Kansas Department of Health and Environment, Bureau of Water, Geology Section, 1 000 SW Jackson St., Ste. 420, Topeka, Kansas 66612-1367. Telephone: 785/296-5522. Send one to Water Well Owner and retain one for your records.

RECEIVED
OCT 25 2006
BUREAU OF WATER