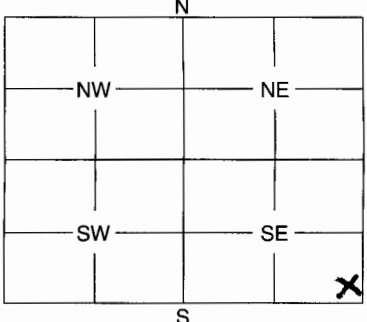
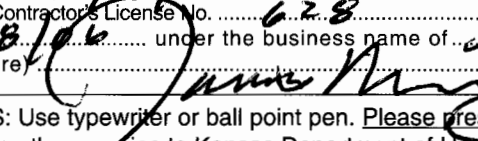


1 LOCATION OF WATER WELL:	Fraction	Section Number	Township Number	Range	Number																					
County: SEDGWICK	SE 1/4 SE 1/4 SE 1/4	24	T 27 S	R 1 W	E/W																					
Distance and direction from nearest town or city street address of well if located within city? 10 A SOUTH OF SOUTHSIDE 253 Richmond Wichita KS																										
2 WATER WELL OWNER: LENA SHELTON 253 Richmond RR #, St. Address, Box #: City, State, ZIP Code : Wichita KS 67213																										
Board of Agriculture, Division of Water Resources Application Number: Unknown																										
3 MARK WELL'S LOCATION WITH AN "X" IN SECTION BOX: 			4 DEPTH OF WELL 25 ft.																							
			WELL'S STATIC WATER LEVEL 16 ft.																							
			WELL WAS USED AS: <table style="width:100%;"><tr><td>1 Domestic</td><td>5 Public Water Supply</td><td>9 Dewatering</td></tr><tr><td>2 Irrigation</td><td>6 Oil Field Water Supply</td><td>10 Monitoring Well</td></tr><tr><td>3 Feedlot</td><td><u>7 Domestic (Lawn & Garden)</u></td><td>11 Injection Well</td></tr><tr><td>4 Industrial</td><td>8 Air Conditioning</td><td>12 Other</td></tr></table>			1 Domestic	5 Public Water Supply	9 Dewatering	2 Irrigation	6 Oil Field Water Supply	10 Monitoring Well	3 Feedlot	<u>7 Domestic (Lawn & Garden)</u>	11 Injection Well	4 Industrial	8 Air Conditioning	12 Other									
1 Domestic	5 Public Water Supply	9 Dewatering																								
2 Irrigation	6 Oil Field Water Supply	10 Monitoring Well																								
3 Feedlot	<u>7 Domestic (Lawn & Garden)</u>	11 Injection Well																								
4 Industrial	8 Air Conditioning	12 Other																								
Was a chemical / bacteriological sample submitted to Department? Yes No X If yes, mo/day/yr sample was submitted																										
Water Well Disinfected: Yes X No																										
5 TYPE OF BLANK CASING USED: <table style="width:100%;"><tr><td><u>1 Steel</u></td><td>3 RMP (SR)</td><td>5 Wrought</td><td>7 Fiberglass</td><td>9 Other (Specify below)</td></tr><tr><td>2 PVC</td><td>4 ABS</td><td>6 Asbestos-Cement</td><td>8 Concrete Tile</td><td></td></tr></table> Blank casing diameter 1 1/4 in. Was casing pulled? Yes X No If yes, how much 1.5 ft Casing height above or below land surface 18 in.						<u>1 Steel</u>	3 RMP (SR)	5 Wrought	7 Fiberglass	9 Other (Specify below)	2 PVC	4 ABS	6 Asbestos-Cement	8 Concrete Tile												
<u>1 Steel</u>	3 RMP (SR)	5 Wrought	7 Fiberglass	9 Other (Specify below)																						
2 PVC	4 ABS	6 Asbestos-Cement	8 Concrete Tile																							
6 GROUT PLUG MATERIAL: 1 Neat cement 2 Cement grout <u>3 Bentonite</u> 4 Other Grout Plug Intervals: From 25 ft. to 1.5 ft., From ft. to ft., From to ft. What is the nearest source of possible contamination: <table style="width:100%;"><tr><td>1 Septic tank</td><td>6 Seepage pit</td><td><u>11 Fuel storage</u></td><td>16 Other (specify below)</td></tr><tr><td>2 Sewer lines</td><td>7 Pit privy</td><td>12 Fertilizer storage</td><td><u>well abandoned</u></td></tr><tr><td>3 Watertight sewer lines</td><td>8 Sewage lagoon</td><td>13 Insecticide storage</td><td></td></tr><tr><td>4 Lateral lines</td><td>9 Feedyard</td><td>14 Abandoned water well</td><td></td></tr><tr><td>5 Cess pool</td><td>10 Livestock pens</td><td>15 Oil well/Gas well</td><td></td></tr></table> Direction from well? SOUTH How many feet? 10						1 Septic tank	6 Seepage pit	<u>11 Fuel storage</u>	16 Other (specify below)	2 Sewer lines	7 Pit privy	12 Fertilizer storage	<u>well abandoned</u>	3 Watertight sewer lines	8 Sewage lagoon	13 Insecticide storage		4 Lateral lines	9 Feedyard	14 Abandoned water well		5 Cess pool	10 Livestock pens	15 Oil well/Gas well		
1 Septic tank	6 Seepage pit	<u>11 Fuel storage</u>	16 Other (specify below)																							
2 Sewer lines	7 Pit privy	12 Fertilizer storage	<u>well abandoned</u>																							
3 Watertight sewer lines	8 Sewage lagoon	13 Insecticide storage																								
4 Lateral lines	9 Feedyard	14 Abandoned water well																								
5 Cess pool	10 Livestock pens	15 Oil well/Gas well																								
<table border="1" style="width:100%; border-collapse: collapse;"><thead><tr><th style="width:15%;">FROM</th><th style="width:15%;">TO</th><th style="width:70%;">PLUGGING MATERIALS</th></tr></thead><tbody><tr><td>1.5</td><td>0</td><td>Topsoil</td></tr><tr><td>25</td><td>1.5</td><td>Bentonite/Bleach</td></tr><tr><td> </td><td> </td><td> </td></tr><tr><td> </td><td> </td><td> </td></tr><tr><td> </td><td> </td><td> </td></tr><tr><td> </td><td> </td><td> </td></tr></tbody></table>						FROM	TO	PLUGGING MATERIALS	1.5	0	Topsoil	25	1.5	Bentonite/Bleach												
FROM	TO	PLUGGING MATERIALS																								
1.5	0	Topsoil																								
25	1.5	Bentonite/Bleach																								
7 CONTRACTOR'S OF LANDOWNER'S CERTIFICATION: This water well was plugged under my jurisdiction and was completed on (mo/day/year) 10/28/06 and this record is true to the best of my knowledge and belief. Kansas Water Well Contractors License No. 628 This Water Well Record was completed on (mo/day/year) 10/28/06 under the business name of JMP Drains by (signature) 																										
INSTRUCTIONS: Use typewriter or ball point pen. Please press firmly and print clearly. Please fill in blanks, underline or circle the correct answers. Send top three copies to Kansas Department of Health and Environment, Bureau of Water, Geology Section, 1000 SW Jackson St., Ste. 420, Topeka, Kansas 66612-1367. Telephone: 785/296-5522. Send one to Water Well Owner and retain one for your records.																										