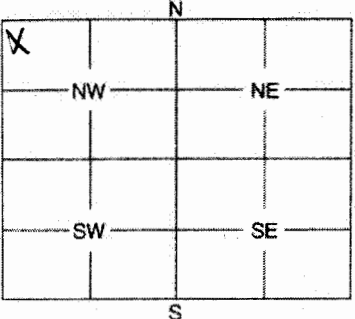


1 LOCATION OF WATER WELL: County: Sedgwick Distance and direction from nearest town or city street address of well if located within city? 240 S. West Street, Wichita, Ks	Fraction NW $\frac{1}{4}$ NW $\frac{1}{4}$ NW $\frac{1}{4}$	Section Number 25	Township Number 27	Range Number 1
--	---	------------------------------------	-------------------------------------	---------------------------------

EW


2 WATER WELL OWNER: Town and Country #73 RR #, St. Address, Box #: 240 S. West Street City, State, ZIP Code : Wichita, Ks	Board of Agriculture, Division of Water Resources Application Number:
---	--

3 MARK WELL'S LOCATION WITH AN "X" IN SECTION BOX: 	4 DEPTH OF WELL 29.2 ft. WELL'S STATIC WATER LEVEL 15.2 ft. WELL WAS USED AS: <table style="width:100%;"> <tr> <td>1 Domestic</td> <td>5 Public Water Supply</td> <td>9 Dewatering</td> </tr> <tr> <td>2 Irrigation</td> <td>6 Oil Field Water Supply</td> <td>☒ 10 Monitoring Well</td> </tr> <tr> <td>3 Feedlot</td> <td>7 Domestic (Lawn & Garden)</td> <td>11 Injection Well</td> </tr> <tr> <td>4 Industrial</td> <td>8 Air Conditioning</td> <td>12 Other</td> </tr> </table> Was a chemical / bacteriological sample submitted to Department? Yes No ☒ X If yes, mo/day/yr sample was submitted Water Well Disinfected: Yes No ☒ X	1 Domestic	5 Public Water Supply	9 Dewatering	2 Irrigation	6 Oil Field Water Supply	☒ 10 Monitoring Well	3 Feedlot	7 Domestic (Lawn & Garden)	11 Injection Well	4 Industrial	8 Air Conditioning	12 Other
1 Domestic	5 Public Water Supply	9 Dewatering											
2 Irrigation	6 Oil Field Water Supply	☒ 10 Monitoring Well											
3 Feedlot	7 Domestic (Lawn & Garden)	11 Injection Well											
4 Industrial	8 Air Conditioning	12 Other											

5 TYPE OF BLANK CASING USED: ☒ Steel ☐ 3 RMP (SR) ☐ 5 Wrought ☐ 7 Fiberglass ☐ 9 Other (Specify below) ☒ PVC ☐ 4 ABS ☐ 6 Asbestos-Cement ☐ 8 Concrete Tile	Blank casing diameter 2 in. Was casing pulled? Yes ☒ X No If yes, how much 3 Casing height above or below land surface in.
---	--

6 GROUT PLUG MATERIAL: Grout Plug Intervals: From 3 ft. to 0 ft. From ft. to ft. From to ft.	☐ 1 Neat cement ☐ 2 Cement grout ☒ 3 Bentonite ☐ 4 Other What is the nearest source of possible contamination: <table style="width:100%;"> <tr> <td>1 Septic tank</td> <td>6 Seepage pit</td> <td>11 Fuel storage</td> <td>☒ 16 Other (specify below)</td> </tr> <tr> <td>2 Sewer lines</td> <td>7 Pit privy</td> <td>12 Fertilizer storage</td> <td>cont. site</td> </tr> <tr> <td>3 Watertight sewer lines</td> <td>8 Sewage lagoon</td> <td>13 Insecticide storage</td> <td></td> </tr> <tr> <td>4 Lateral lines</td> <td>9 Feedyard</td> <td>14 Abandoned water well</td> <td></td> </tr> <tr> <td>5 Cess pool</td> <td>10 Livestock pens</td> <td>15 Oil well/Gas well</td> <td></td> </tr> </table> Direction from well? How many feet?	1 Septic tank	6 Seepage pit	11 Fuel storage	☒ 16 Other (specify below)	2 Sewer lines	7 Pit privy	12 Fertilizer storage	cont. site	3 Watertight sewer lines	8 Sewage lagoon	13 Insecticide storage		4 Lateral lines	9 Feedyard	14 Abandoned water well		5 Cess pool	10 Livestock pens	15 Oil well/Gas well	
1 Septic tank	6 Seepage pit	11 Fuel storage	☒ 16 Other (specify below)																		
2 Sewer lines	7 Pit privy	12 Fertilizer storage	cont. site																		
3 Watertight sewer lines	8 Sewage lagoon	13 Insecticide storage																			
4 Lateral lines	9 Feedyard	14 Abandoned water well																			
5 Cess pool	10 Livestock pens	15 Oil well/Gas well																			

FROM	TO	PLUGGING MATERIALS
3	0	Bentonite grout

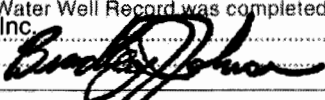7 CONTRACTOR'S OF LANDOWNER'S CERTIFICATION: (mo/day/year) 11/07/06 and this record is true to the best of my knowledge and belief. Kansas Water Well Contractor's License No. 585 This Water Well Record was completed on (mo/day/year) 11/28/06 under the business name of Associated Environmental, Inc. by (signature) B. Johnson	
--	--

INSTRUCTIONS: Use typewriter or ball point pen. Please press firmly and print clearly. Please fill in blanks, underline or circle the correct answers. Send top three copies to Kansas Department of Health and Environment, Bureau of Water, Geology Section, 1000 SW Jackson St., Ste. 420, Topeka, Kansas 66612-1367. Telephone: 785/296-5522. Send one to Water Well Owner and retain one for your records.