


1 LOCATION OF WATER WELL:		Fraction	Section Number		Township Number		Range Number	
County:	Sedgwick	NW $\frac{1}{4}$ NW $\frac{1}{4}$ NE $\frac{1}{4}$	31		27		1	

Distance and direction from nearest town or city street address of well if located within city?
11209 West Hwy 54, Wichita

2 WATER WELL OWNER: **Blasi Tire-KDHE Time and Materials**
RR#, St. Address, Box # : **1000 SW Jackson #410** Board of Agriculture, Division of Water Resources
City, State, ZIP Code : **Topeka, Ks 66612-1367** Application Number: _____

3 LOCATE WELL'S LOCATION WITH AN "X" IN SECTION BOX: 4 DEPTH OF COMPLETED WELL: 35.5 ft. ELEVATION: _____

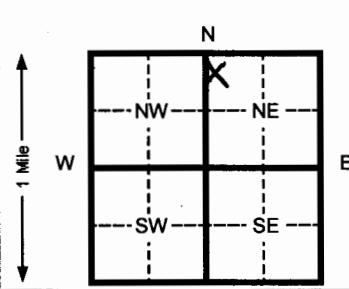

4 DEPTH OF COMPLETED WELL 35.5 ft. ELEVATION: _____

Depth(s) Groundwater Encountered 11.5 ft. 2 _____ ft. 3 _____ Ft.

WELL'S STATIC WATER LEVEL 23.65 ft. below land surface measured on mo/day/yr 01/11/07

Pump test data: Well water was _____ Ft. after _____ hours pumping _____ Gpm

Est. Yield _____ Gpm: Well water was _____ Ft. after _____ Hours pumping _____ Gpm

Bore Hole Diameter 8.625 in. to 35.5 Ft. and _____ in. to _____ Ft.

WELL WATER TO BE USED AS:

5 Public water supply	8 Air conditioning	11 Injection well
1 Domestic	3 Feed lot	6 Oil field water supply
2 Irrigation	4 Industrial	7 Lawn and garden (domestic)
9 Dewatering	12 Other (Specify below)	

10 Monitoring well **MW-2R**

Was a chemical/bacteriological sample submitted to Department? Yes _____ No X If yes, mo/day/yr sample was Submitted _____

Water Well Disinfected? Yes _____ No X

5 TYPE OF BLANK CASING USED:		5 Wrought Iron	8 Concrete tile	CASING JOINTS: Glued _____ Clamped _____	
1 Steel	3 RMP (SR)	6 Asbestos-Cement	9 Other (specify below)	Welded	
2 PVC	4 ABS	7 Fiberglass		Threaded	X

Blank casing diameter 2 in. to 20 Ft., Dia in. to Ft., Dia in. to ft.
Casing height above land surface FLUSH in., weight SCH 40 Lbs./ft. Wall thickness or gauge No.

TYPE OF SCREEN OR PERFORATION MATERIAL:			7	PVC	10	Asbestos-cement			
1	Steel	3	Stainless steel	5	Fiberglass	8	RMP (SR)	11	Other (specify) _____
2	Brass	4	Galvanized steel	6	Concrete tile	9	ABS	12	None used (open hole)
SCREEN OR PERFORATION OPENINGS ARE:			5	Gauzed wrapped	8	Saw cut	11	None (open hole)	
1	Continuous slot	3	Mill slot	6	Wire wrapped	9	Drilled holes		
2	Louvered shutter	4	Key punched	7	Torch cut	10	Other (specify) _____		

SCREEN-PERFORATED INTERVALS:	From	20	ft. to	35.5	ft. From		ft. to		ft.
	From		ft. to		ft. From		ft. to		Ft.
SAND PACK INTERVALS:	From	18	ft. to	35.5	ft. From		ft. to		Ft.
	From		ft. to		ft. From		ft. to		Ft.

6 GROUT MATERIAL: 1 Neat cement 2 Cement grout 3 Bentonite 4 Other _____

Grout Intervals From 3 0 ft. to 16 Ft. From 2 16 Ft. to 18 ft. From _____ ft. to _____ ft.

What is the nearest source of possible contamination:			10 Livestock pens	14 Abandoned water well
1 Septic tank	4 Lateral lines	7 Pit privy	11 Fuel storage	15 Oil well/ Gas well
2 Sewer lines	5 Cess pool	8 Sewage lagoon	12 Fertilizer storage	16 Other (specify below)
3 Watertight sewer lines	6 Seepage pit	9 Feedyard	13 Insecticide storage	
Direction from well?			How many feet?	Contaminated Site

[illegible]

7] CONTRACTOR'S OR LANDOWNER'S CERTIFICATION: This water well was (x) constructed, (2) reconstructed, or (3) plugged under my jurisdiction and was Completed on (mo/day/yr) **12/7/06** And this record is true to the best of my knowledge and belief. Kansas Water Well Contractor's License No. **585** This Water Well Record was completed on (mo/day/yr) **1/7/07** under the business name of **Associated Environmental, Inc.** By (signature) **Bradley J Johnson**

INSTRUCTIONS: Please fill in blanks and circle the correct answers. Send three copies to Kansas Department of Health and Environment, Bureau of Water, Topeka, Kansas 66620-0001. Telephone: 913-296-5545. Send one to WATER WELL OWNER and retain one for your records.